


Township 10.5 Range 2.8.3.4, W.M.
North

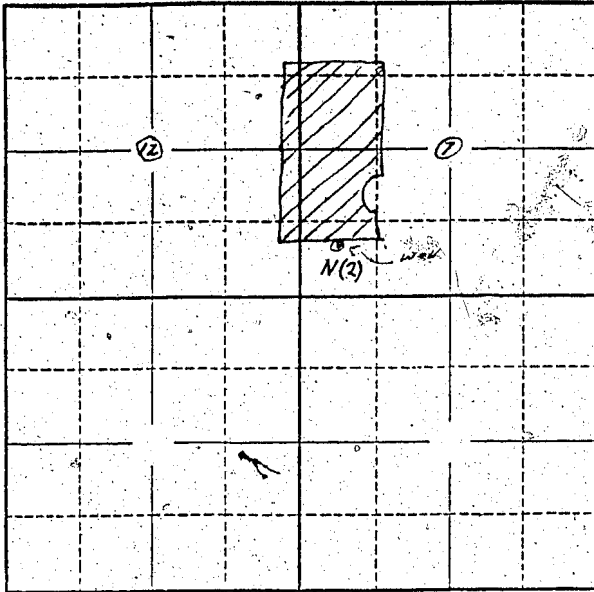

Locate well and acreage of irrigated land on plat.

Scale: 2" = 1 Mile

STATE OF OREGON

County of Marion } ss.

I, _____, being first duly sworn, do hereby certify that I have read the foregoing Registration Statement and that all of the items therein contained are true to the best of my knowledge and belief.

(Signature of Registrant)

Subscribed and sworn to before me this 14th day of March, 1958.

My commission expires _____
MY COMMISSION EXPIRES JULY 25, 1960.

(Notary Public)

(SEAL)

CERTIFICATE OF REGISTRATION

STATE OF OREGON } ss.
County of Marion

This is to certify that the foregoing Registration Statement was received in the office of the State Engineer on the _____ day of March, 1958, at _____ o'clock _____ M. and has been duly recorded in said office in Book No. 6 of Registration Statements on page GR-1135.

Witness my hand this 28 day of August, 1958.

(State Engineer)

By _____
(Deputy)