


Township 6 N Range 35 E, W.M.

North

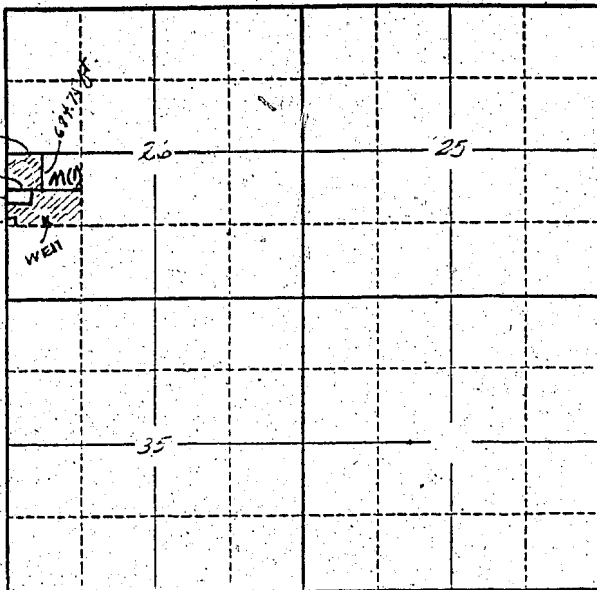

Locate well and acreage of irrigated land on plat.

Scale: 2" = 1 Mile

STATE OF ~~OREGON~~ WASHINGTON

County of YAKIMA

} ss.

I, Wilbur Stadelman, being first duly sworn, do hereby certify that I have read the foregoing Registration Statement and that all of the items therein contained are true to the best of my knowledge and belief.

Wilbur Stadelman
(Signature of Registrant)

Subscribed and sworn to before me this 10th day of March, 19 58.

My commission expires Aug 12, 1959

Martin Rennie
(Notary Public)

(SEAL)

CERTIFICATE OF REGISTRATION

STATE OF OREGON

County of Marion

} ss.

This is to certify that the foregoing Registration Statement was received in the office of the State Engineer on the 14 day of March, 1958, at 9:00 o'clock A. M. and has been duly recorded in said office in Book No. 6 of Registration Statements on page GR-1111

Witness my hand this 28 day of August, 19 58.

Lewis A. Stanley
(State Engineer)

By

(Deputy)

GR-1111