


SW 1/4 of NW 1/4 Sec 31

Township 6N Range 36E W.M.

North

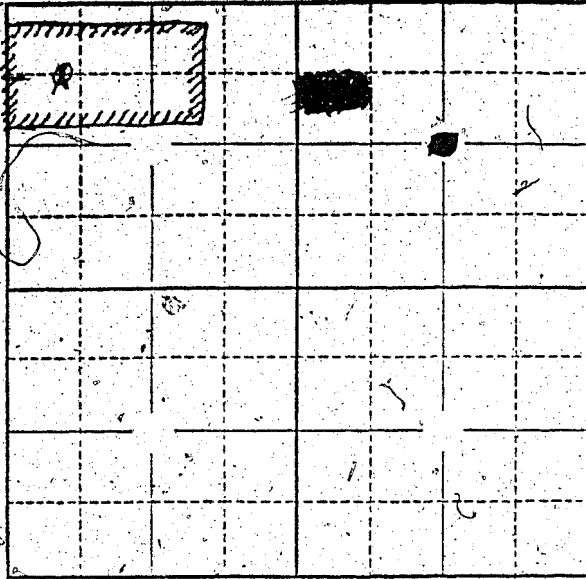

Well is located 164 ft South and 132 ft East of NW corner of Quarter.

Locate well and acreage of irrigated land on plat.

Scale: 2" = 1 Mile

STATE OF OREGON

County of Umatilla } ss.

I, Edward McEwen, being first duly sworn, do hereby certify that I have read the foregoing Registration Statement and that all of the items therein contained are true to the best of my knowledge and belief.

Chris B. Jones

(Signature of Registrant)

Subscribed and sworn to before me this 14 day of March, 1958.

My commission expires July 18 - 1960
Edward McEwen
(Notary Public)

(SEAL)

CERTIFICATE OF REGISTRATION

STATE OF OREGON } ss.
County of Marion

This is to certify that the foregoing Registration Statement was received in the office of the State Engineer on the 17 day of March, 1958, at 8:10 o'clock A. M. and has been duly recorded in said office in Book No. 6 of Registration Statements on page GR-1151.

Witness my hand this 17 day of September, 1958.
Lewis A. Stanley
(State Engineer)

By _____
(Deputy)