


well  
Township 15S Range 4W W.M.  
North

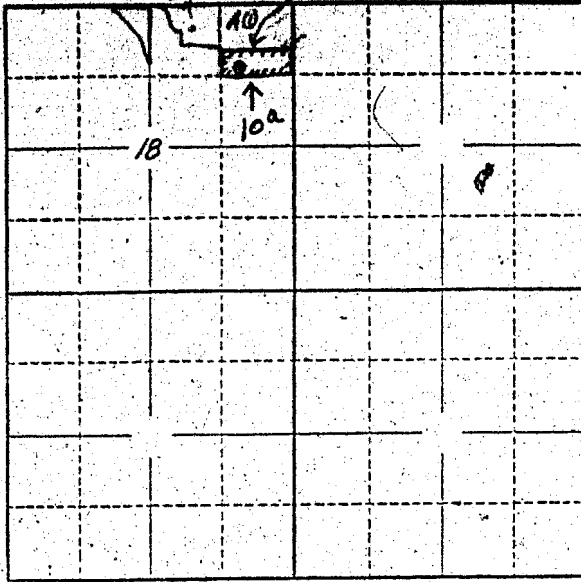

Locate well and acreage of irrigated land on plat.  
Scale: 2" = 1 Mile

STATE OF OREGON

County of Lincoln } ss.

I, Henry Pace, being first duly sworn, do hereby certify that I have read the foregoing Registration Statement and that all of the items therein contained are true to the best of my knowledge and belief.

Henry Pace  
(Signature of Registrant)

Subscribed and sworn to before me this 4th day of April, 1958

My commission expires 8/10/59  
Ray Zeln  
(Notary Public)

(SEAL)

**CERTIFICATE OF REGISTRATION**

STATE OF OREGON

County of Marion } ss.

This is to certify that the foregoing Registration Statement was received in the office of the State Engineer on the 18th day of March, 1958, at 10:00 o'clock AM and has been duly recorded in said office in Book No. 6 of Registration Statements on page GR-1174

Witness my hand this 17 day of September, 1958

Lewis A. Stanley  
(State Engineer)

By \_\_\_\_\_  
(Deputy)