


Section 36

Township 6 N, Range 35 E, W.M.

North

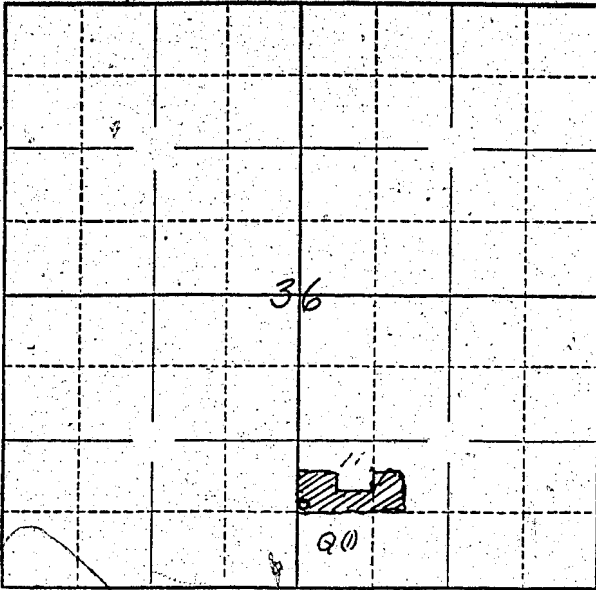

Locate well and acreage of irrigated land on plat.

Scale: 4" = 1 Mile

STATE OF OREGON

County of Washington } ss.

I, Francis R. [unclear], being first duly sworn, do hereby certify that I have read the foregoing Registration Statement and that all of the items therein contained are true to the best of my knowledge and belief.

Francis R. [unclear]
(Signature of Registrant)

Subscribed and sworn to before me this 15 day of March, 1958.

My commission expires 1959 [unclear]
(Notary Public)

(SEAL)

CERTIFICATE OF REGISTRATION

STATE OF OREGON

County of Marion } ss.

This is to certify that the foregoing Registration Statement was received in the office of the State Engineer on the 19th day of March, 1958, at 1:00 o'clock P. M. and has been duly recorded in said office in Book No. 6 of Registration Statements on page GR-1177

Witness my hand this 17 day of September, 1958.

Lewis A. Stanley
(State Engineer)

By _____
(Deputy)

\$15.00

GR-1177