


Township 75 Range 3W W.M.

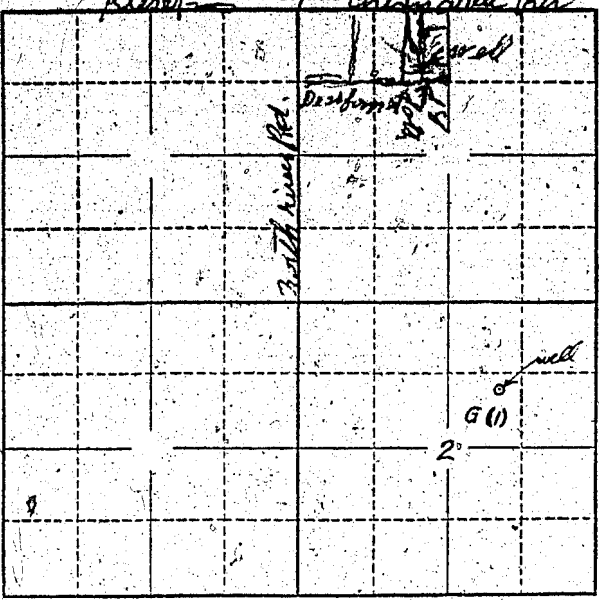

Locate well and acreage of irrigated land on plat.

Scale: 2" = 1 Mile

STATE OF OREGON

County of Marion } ss.

I, Ernest E. Porter being first duly sworn, do hereby certify that I have read the foregoing Registration Statement and that all of the items therein contained are true to the best of my knowledge and belief.

Ernest E. Porter  
(Signature of Registrant)

Subscribed and sworn to before me this 24th day of March, 1958

My commission expires 9/27/58  
Jeanie Baxter  
(Notary Public)

(SEAL)

**CERTIFICATE OF REGISTRATION**

STATE OF OREGON

County of Marion } ss.

This is to certify that the foregoing Registration Statement was received in the office of the State Engineer on the 20 day of March, 1958, at 2:45 o'clock P. M. and has been duly recorded in said office in Book No. 6 of Registration Statements on page GR-1184

Witness my hand this 17 day of September, 1958

Laura A. Stanley  
(State Engineer)

By \_\_\_\_\_ (Deputy)

1500