


North

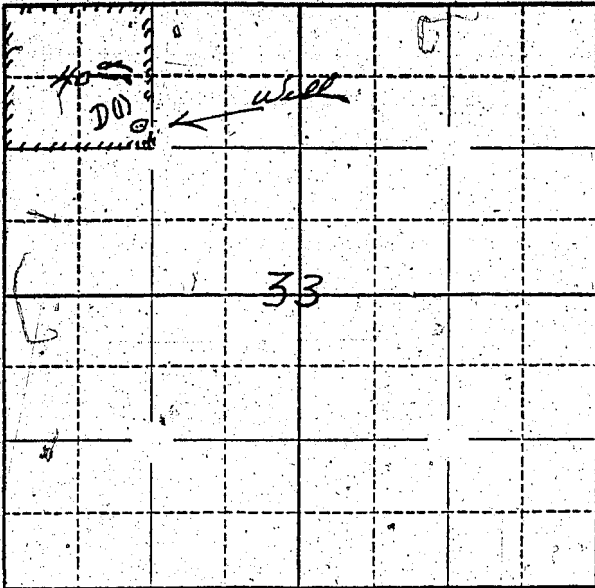

Locate well and acreage of irrigated land on plat.

Scale: $\frac{1}{4}$ " = 1 Mile

STATE OF OREGON


I, Pete Gow, being first duly sworn, do hereby certify that I have read the foregoing Registration Statement and that all of the items therein contained are true to the best of my knowledge and belief.

Pete Gow
(Signature of Registrant)

Subscribed and sworn to before me this 21 day of March, 1958.

My commission expires 6/24/59 J.A. Sullivan
(Notary Public)

(SEAL)

CERTIFICATE OF REGISTRATION

STATE OF OREGON

County of Marion } ss.

This is to certify that the foregoing Registration Statement was received in the office of the State Engineer on the 24th day of March, 1958, at 8:00 o'clock A.M. and has been duly recorded in said office in Book No. 6 of Registration Statements on page GR-1193

Witness my hand this 17 day of September, 1958.

Lewis A. Stanley
(State Engineer)

By _____ (Deputy)

\$16.50