


No. 58-3-38  
Water Rights Survey  
for  
Roy Wooldridge

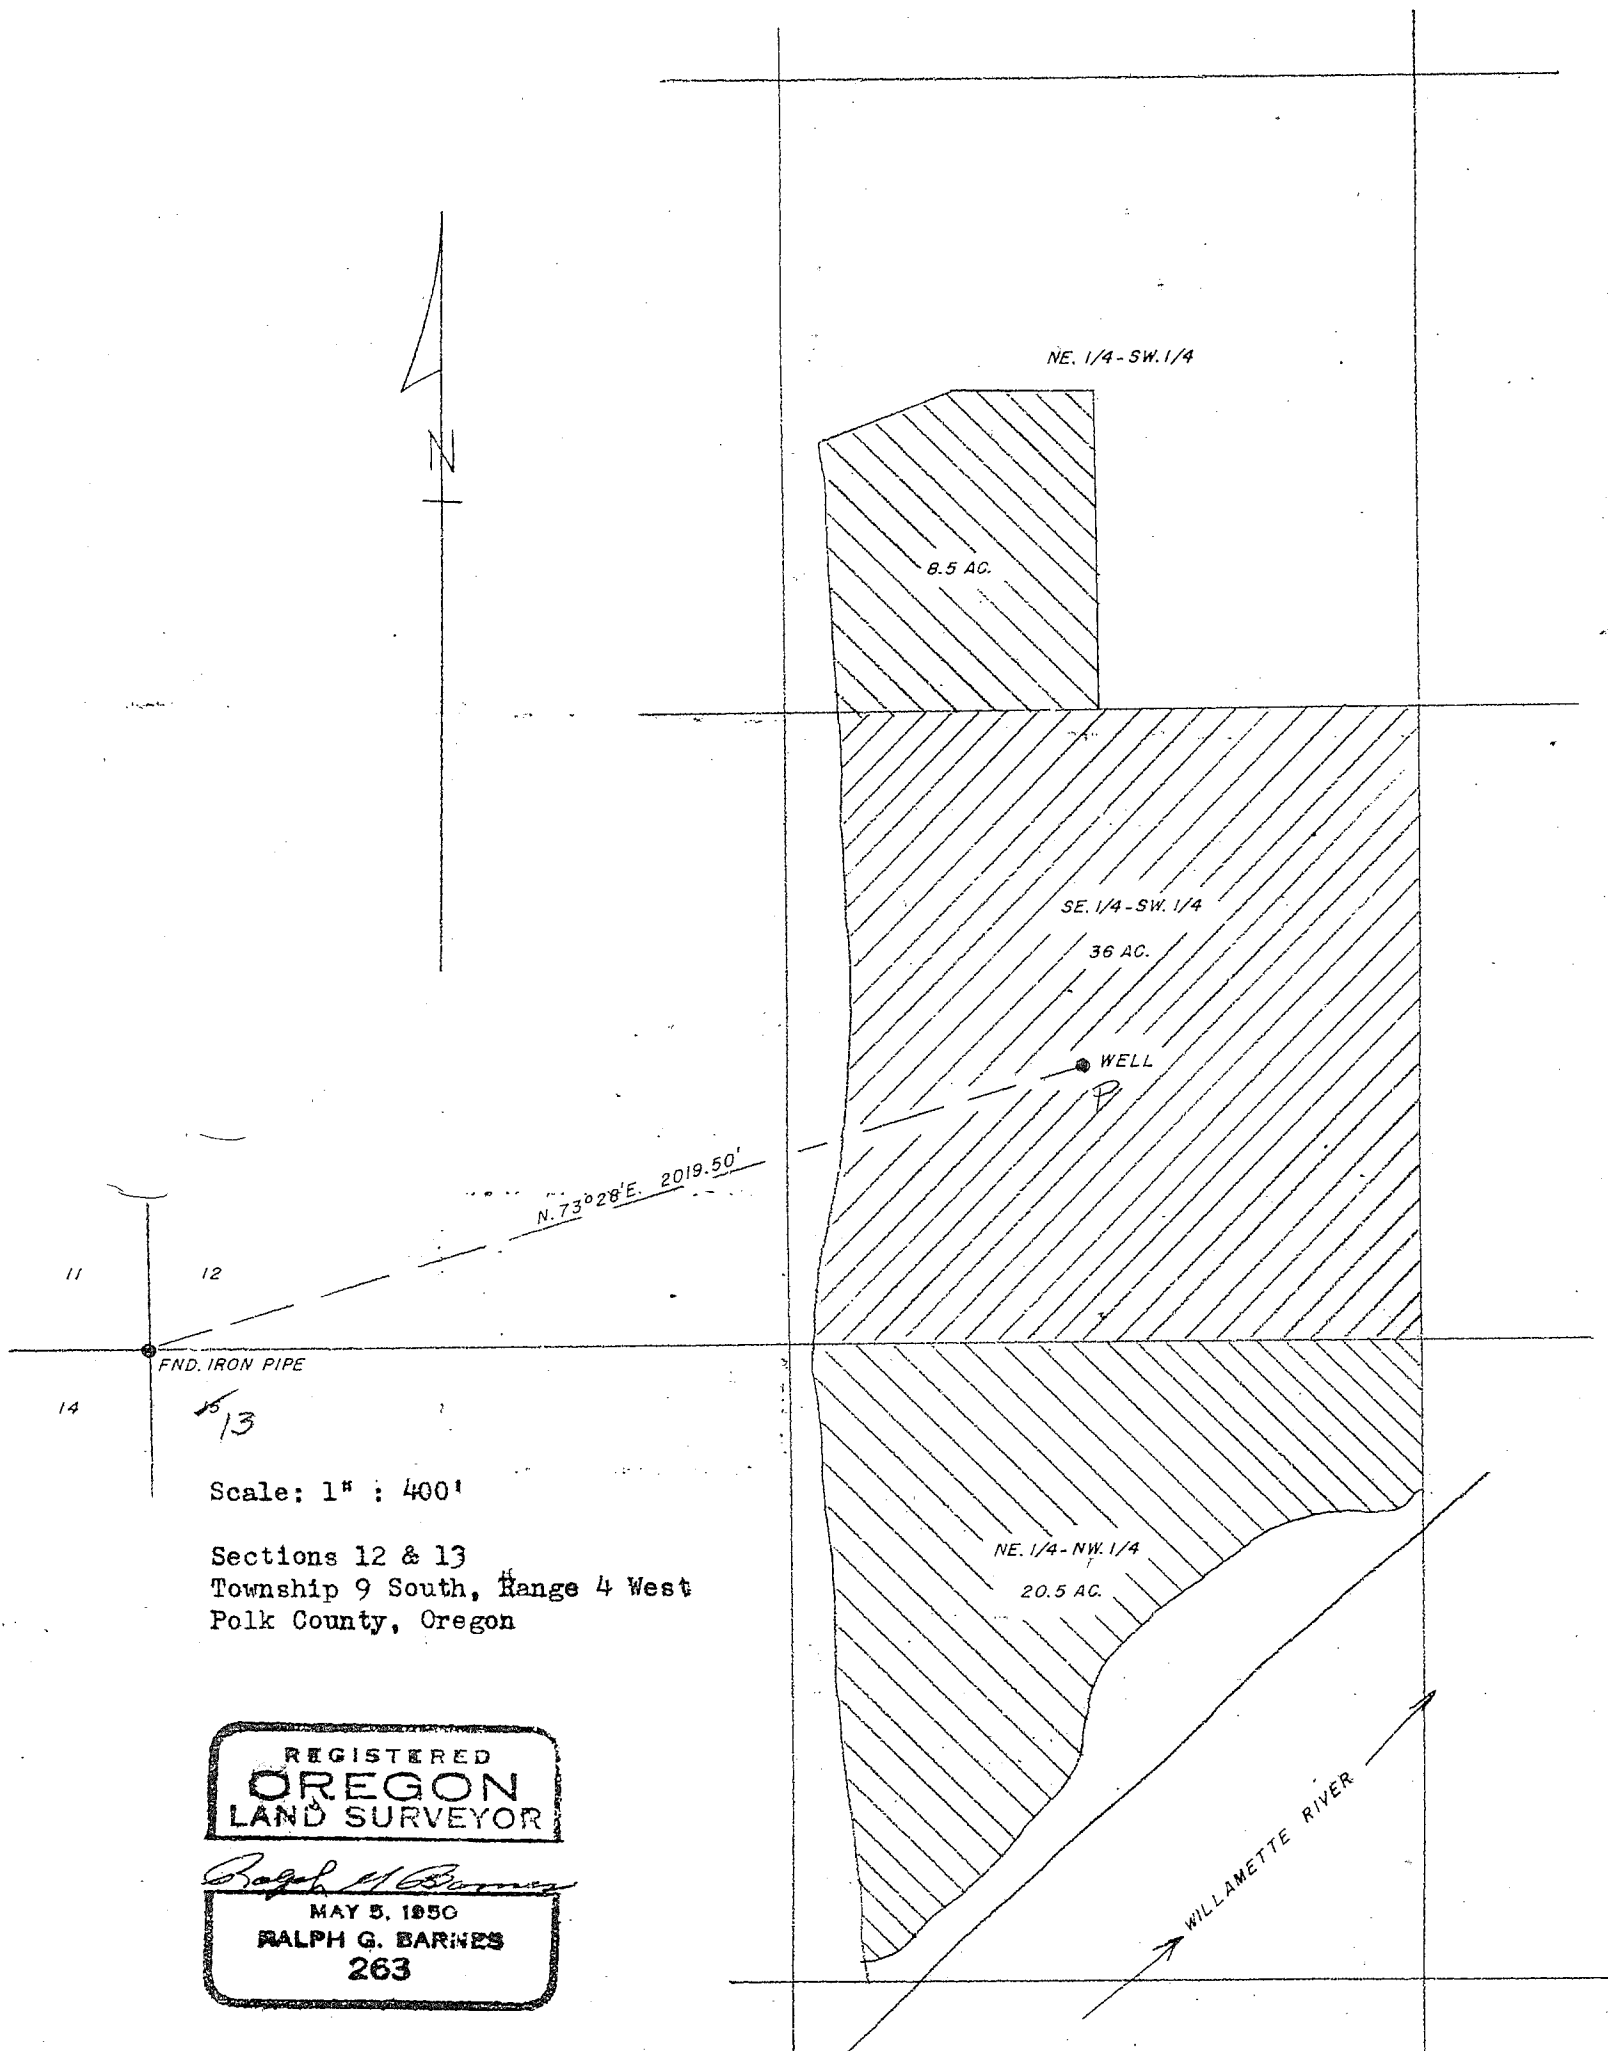

I, Ralph G. Barnes, Registered Land Surveyor, 990 Shipping Street, Salem, Oregon, do hereby certify that this map was made from notes taken during an actual survey made by me on March 5, 1958.

*Ralph G. Barnes*

GR 1235