


North

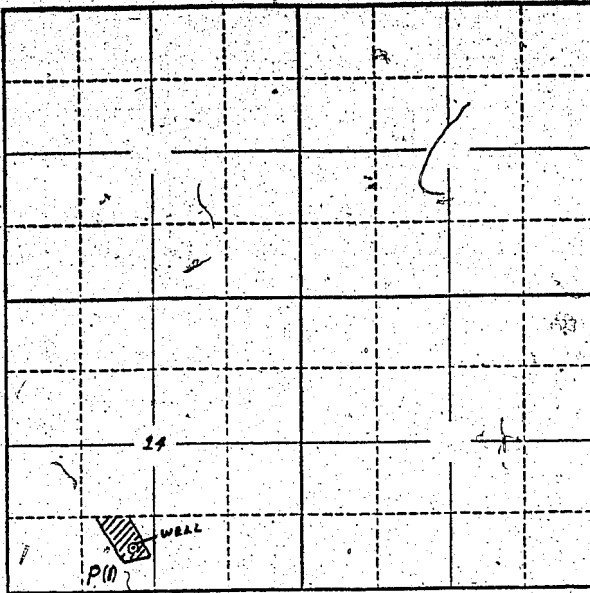

Locate well and acreage of irrigated land on plat.

Scale: 2" = 1 Mile

STATE OF OREGON

County of Lane

SS:

I, Vincent Glover, being first duly sworn, do hereby certify that I have read the foregoing Registration Statement and that all of the items therein contained are true to the best of my knowledge and belief.

Vincent Glover
(Signature of Registrant)

Subscribed and sworn to before me this 22 day of March, 1958.

My commission expires April 20, 1960

Wm. Peterson
(Notary Public)

(SEAL)

CERTIFICATE OF REGISTRATION

STATE OF OREGON

County of Marion

SS:

This is to certify that the foregoing Registration Statement was received in the office of the State Engineer on the 24th day of March, 1958, at 10⁰⁰ o'clock A. M. and has been duly recorded in said office in Book No. 6 of Registration Statements on page GR-1196

Witness my hand this 17 day of September, 1958

Lewis A. Ottaway
(State Engineer)

By _____ (Deputy)