


sect 1

Township 5 N Range 35 E, W.M.

North

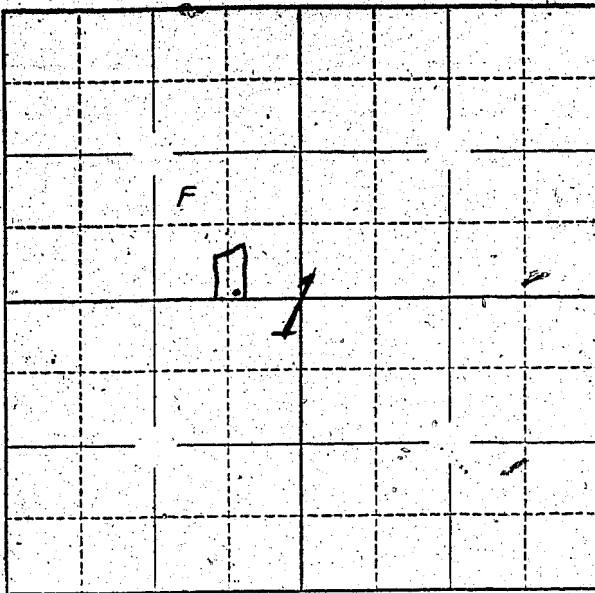

Locate well and acreage of irrigated land on plat.

Scale: 1/4" = 1 Mile

STATE OF OREGON

County of Umatilla } ss.

I, Orval Mason, being first duly sworn, do hereby certify that I have read the foregoing Registration Statement and that all of the items therein contained are true to the best of my knowledge and belief.

Orval Mason
(Signature of Registrant)

Subscribed and sworn to before me this 22nd day of March, 1958.

My commission expires July 22, 1959

Allan MacMillan
(Notary Public)

(SEAL)

CERTIFICATE OF REGISTRATION

STATE OF OREGON

County of Marion } ss.

This is to certify that the foregoing Registration Statement was received in the office of the State Engineer on the 24th day of March, 1958, at 8:00 o'clock A.M. and has been duly recorded in said office in Book No. 6 of Registration Statements on page GR-1200

Witness my hand this 17 day of September, 1958

Leura A. Stanley
(State Engineer)

By _____ (Deputy)

\$15.00

GR - 1200