


North

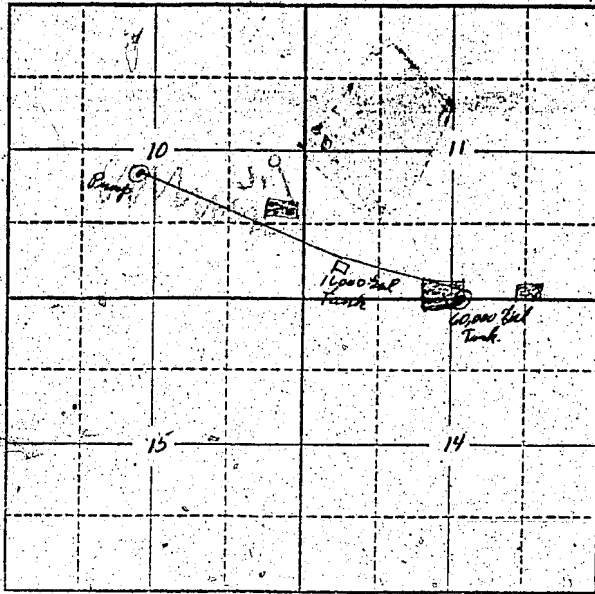

Locate well and acreage of irrigated land on plat.

Scale: 2" = 1 Mile

STATE OF OREGON

County of Marion

ss.

I, Hilary Grantz, being first duly sworn, do hereby certify that I have read the foregoing Registration Statement and that all of the items therein contained are true to the best of my knowledge and belief.

Hilary Grantz
Hilary Grantz
(Signature of Registrant)

Subscribed and sworn to before me this 23rd day of January, 1956

My commission expires Aug 9, 1960

[Signature]
(Notary Public)

(SEAL)

CERTIFICATE OF REGISTRATION

STATE OF OREGON

County of Marion

ss.

This is to certify that the foregoing Registration Statement was received in the office of the State Engineer on the 24th day of February, 1956, at 4:30 o'clock P.M. and has been duly recorded in said office in Book No. 1 of Registration Statements on page GR-116C

~~Construction shall be completed by _____ and the water completely supplied to beneficial use by _____~~

Witness my hand this 12th day of April, 1956

Lewis A. Stanley
(State Engineer)

By _____ (Deputy)