


Township 9s Range 3w, W.M.
North

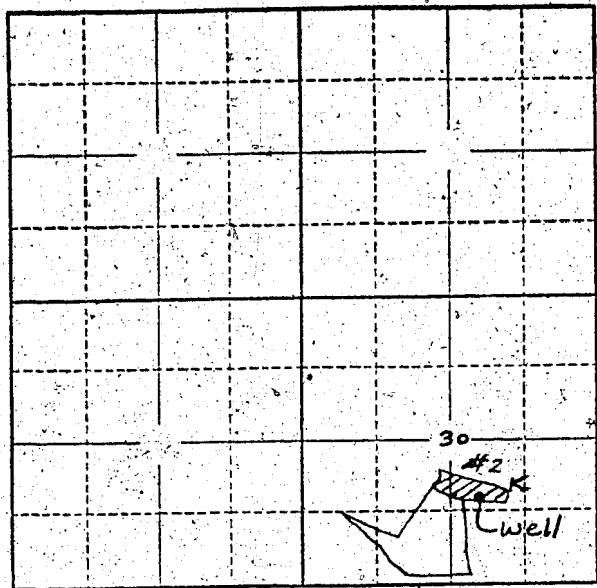

Locate well and acreage of irrigated land on plat.
Scale: 2" = 1 Mile

STATE OF OREGON }
County of _____ } ss.

I, _____, being first duly sworn, do hereby certify that I have read the foregoing Registration Statement and that all of the items therein contained are true to the best of my knowledge and belief.

(Signature of Registrant)

Subscribed and sworn to before me this _____ day of _____, 19____.

My commission expires _____
(Notary Public)

(SEAL)

CERTIFICATE OF REGISTRATION

STATE OF OREGON }
County of Marion } ss.

This is to certify that the foregoing Registration Statement was received in the office of the State Engineer on the 25 day of MARCH, 1958, at 1.50 o'clock P. M. and has been duly recorded in said office in Book No. 6 of Registration Statements on page GR 1213

Witness my hand this 19 day of September, 1958

Lawrence A. Stanley
(State Engineer)

By _____
(Deputy)