


Township 1S Range 2W W.M.
North.

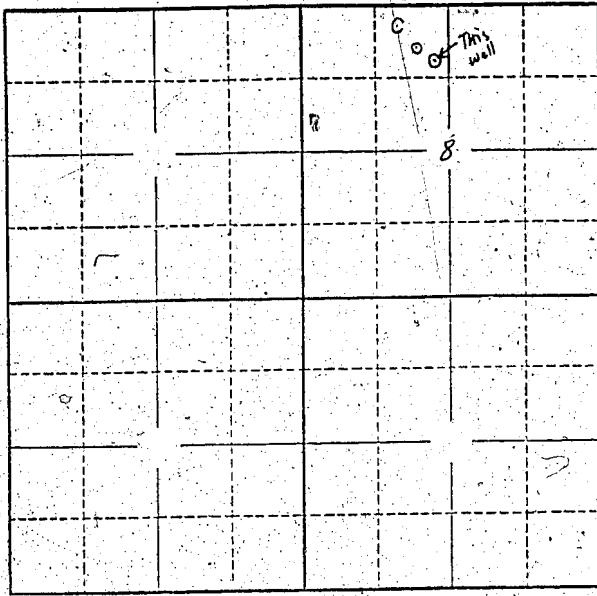

Locate well and acreage of irrigated land on plat.

Scale: 2" = 1 Mile

STATE OF OREGON

County of Washington } ss.

I, German & Freudensthal, being first duly sworn, do hereby certify that I have read the foregoing Registration Statement and that all of the items therein contained are true to the best of my knowledge and belief.

German / Freudensthal
(Signature of Registrant)

Subscribed and sworn to before me this 26 day of March, 1958.

expires Dec. 7-1959
Clyde Hunt
(Notary Public)



CERTIFICATE OF REGISTRATION

STATE OF OREGON } ss.
County of Marion

This is to certify that the foregoing Registration Statement was received in the office of the State Engineer on the _____ day of _____, 19____, at _____ o'clock _____ M. and has been duly recorded in said office in Book No. 6 of Registration Statements on page GR-1233

Witness my hand this 19 day of September, 1958
Lewis A. Stanley
(State Engineer)

By _____
(Deputy)

GR - 1233