


Township 25 Range R1W W.M.  
North

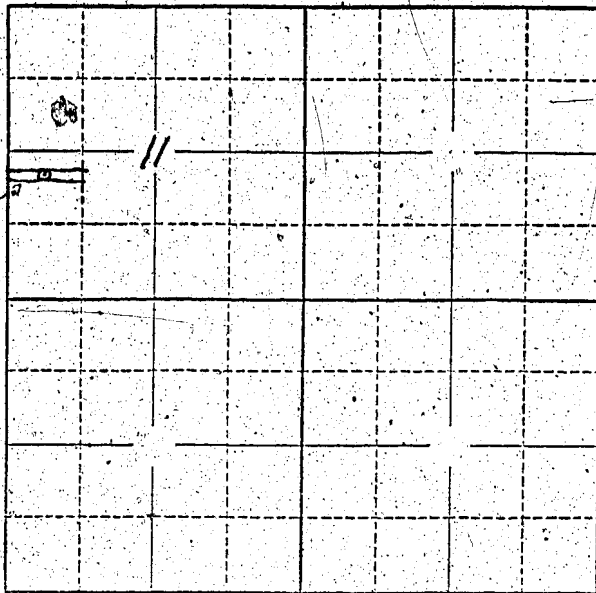

Locate well and acreage of irrigated land on plat.  
Scale: 2" = 1 Mile

STATE OF OREGON

County of Washington } ss.

I, Walter H. Engler, being first duly sworn, do hereby certify that I have read the foregoing Registration Statement and that all of the items therein contained are true to the best of my knowledge and belief.

Walter H. Engler  
Walter H. Engler  
(Signature of Registrant)

Subscribed and sworn to before me this 20 day of \_\_\_\_\_, 19\_\_\_\_

My commission expires \_\_\_\_\_

James M. Benken  
(Notary Public)

(SEAL)

**CERTIFICATE OF REGISTRATION**

STATE OF OREGON

County of Marion } ss.

"This is to certify that the foregoing Registration Statement was received in the office of the State Engineer on the 23rd day of February, 1956, at 8:00 o'clock A. M. and has been duly recorded in said office in Book No. 1 of Registration Statements on page GR-122C



Witness my hand this 12th day of April, 1956

Lewis A. Stanley  
(State Engineer)

By \_\_\_\_\_  
(Deputy)