


SE 1/4 of Sec 27

Township 6N Range 35E, W.M.

North

Well located 3/4
640 ft E and
825 ft South
of NW corner
of NW 1/4

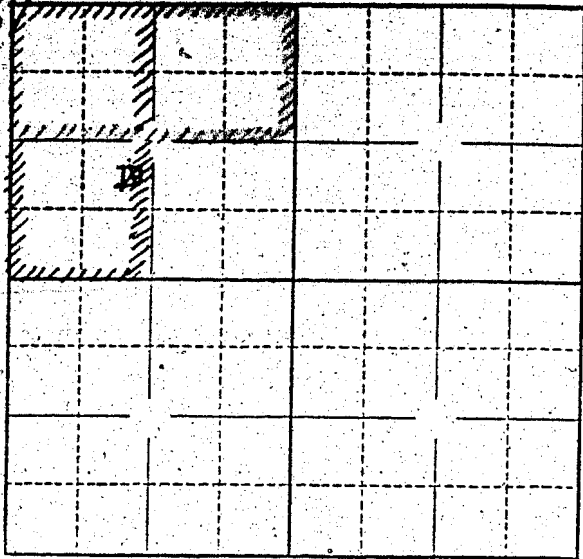

Locate well and acreage of irrigated land on plat.

Scale: 1" = 1 Mile
8"

STATE OF OREGON

County of Umatilla

ss.

I, Benny LeFore, being first duly sworn, do hereby certify that I have read the foregoing Registration Statement and that all of the items therein contained are true to the best of my knowledge and belief.

Benny LeFore
(Signature of Registrant)

Subscribed and sworn to before me this 1st day of April, 1958

My commission expires October 6th, 1960

[Signature]
(Notary Public)

(SEAL)

CERTIFICATE OF REGISTRATION

STATE OF OREGON

County of Marion

ss.

This is to certify that the foregoing Registration Statement was received in the office of the State Engineer on the 2nd day of April, 1958, at 5:00 o'clock A.M. and has been duly recorded in said office in Book No. 6 of Registration Statements on page GR-1267

Witness my hand this 20th day of October, 1958

[Signature]
(State Engineer)

By _____
(Deputy)

GR - 1267