


North

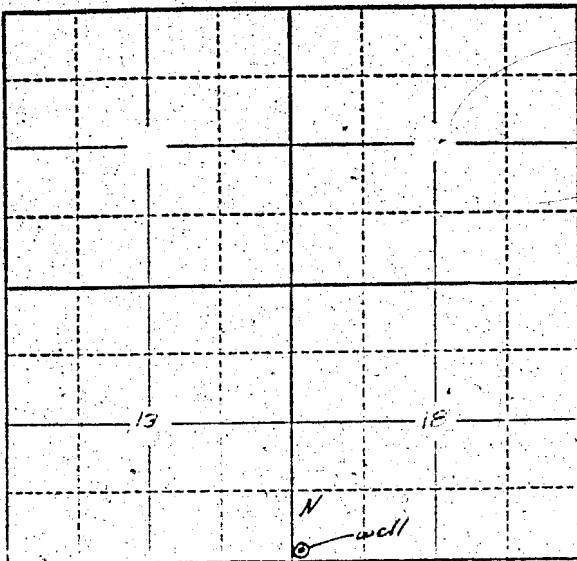

Locate well and acreage of irrigated land on plat.

Scale: 2" = 1 Mile

STATE OF OREGON

County of Marion ss.

I, Albert L. Cox, being first duly sworn, do hereby certify that I have read the foregoing Registration Statement and that all of the items therein contained are true to the best of my knowledge and belief.

Albert L. Cox  
(Signature of Registrant)

Subscribed and sworn to before me this 1st day of April, 1958.

My commission expires 12th June 1961. Wm. D. Bartholomew  
(Notary Public)

(SEAL)

**CERTIFICATE OF REGISTRATION**

STATE OF OREGON }  
County of Marion } ss.

This is to certify that the foregoing Registration Statement was received in the office of the State Engineer on the 2nd day of April, 1958, at 5:00 o'clock A. M. and has been duly recorded in said office in Book No. 6 of Registration Statements on page GR 1268

~~Consent to challenge completed by \_\_\_\_\_ on \_\_\_\_\_ and the same is hereby applied for \_\_\_\_\_~~  
~~\_\_\_\_\_~~

Witness my hand this 20th day of October, 1958  
Edw. A. Dunning  
(State Engineer)

By \_\_\_\_\_ (Deputy) GR 1268