


North

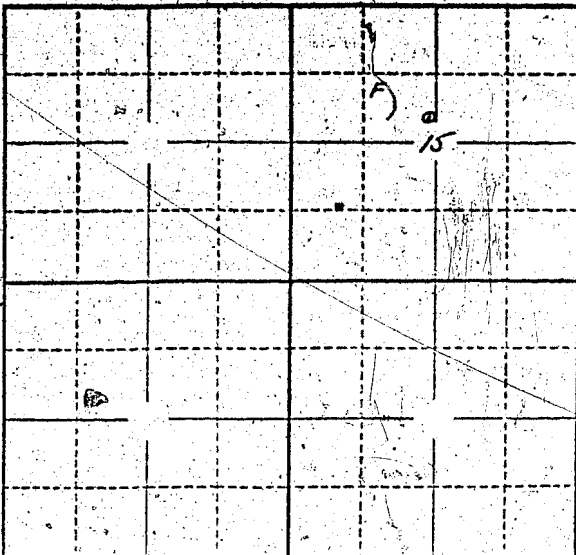

Locate well and acreage of irrigated land on plat.

Scale: 2" = 1 Mile

STATE OF OREGON

County of LINN } ss.

I, R. E. or Bessie J. Bierly being first duly sworn, do hereby certify that I have read the foregoing Registration Statement and that all of the items therein contained are true to the best of my knowledge and belief.

*R. E. Bierly*  
(Signature of Registrant)

Subscribed and sworn to before me this 27th day of March, 19 58.

My commission expires AUGUST 13, 1958

*Wm. W. ...*  
(Notary Public)

(SEAL)

**CERTIFICATE OF REGISTRATION**

STATE OF OREGON }  
County of Marion } ss.

This is to certify that the foregoing Registration Statement was received in the office of the State Engineer on the 1st day of April, 1958, at 5:00 o'clock A. M. and has been duly recorded in said office in Book No. 6 of Registration Statements on page GR-1273

Witness my hand this 20th day of October, 19 58

*Lewis A. Stanley*  
(State Engineer)

By \_\_\_\_\_ (Deputy)