


Irrigated area
2.2. A

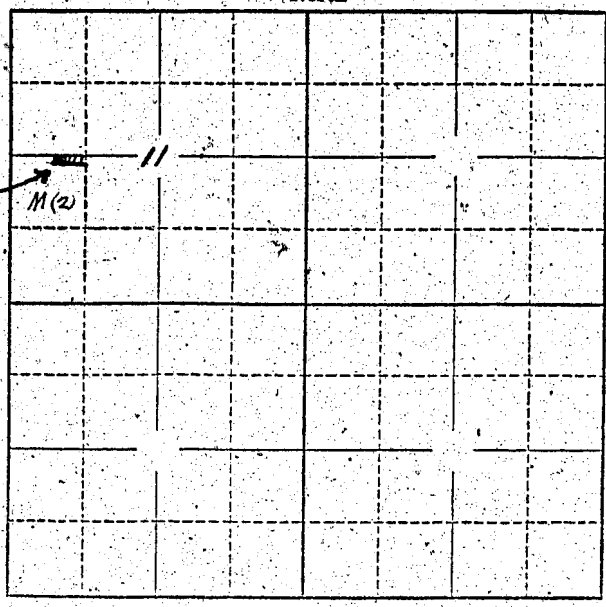

Locate well and acreage of irrigated land on plat.
Scale: 2" = 1 Mile

STATE OF OREGON

County of Washington } ss.

I, Howard William Boyte and
I, Marilyn K. Boyte, being first duly sworn, do hereby certify that I have read the foregoing Registration Statement and that all of the items therein contained are true to the best of my knowledge and belief.

Marilyn K. Boyte

Howard Boyte
(Signature of Registrant)

Subscribed and sworn to before me this 21st day of February, 1956.

My commission expires Oct. 25, 1958

Thelma M. W. Jones
(Notary Public)

(SEAL)

CERTIFICATE OF REGISTRATION

STATE OF OREGON } ss.
County of Marion

This is to certify that the foregoing Registration Statement was received in the office of the State Engineer on the 23rd day of February, 1956, at 8:00 o'clock A.M. and has been duly recorded in said office in Book No. 1 of Registration Statements on page GR-123C.

~~Construction shall be completed by 1956 and the water completely applied for benefit use by 1956.~~

Witness my hand this 12th day of April, 1956.

Levi A. Estabier
(State Engineer)

By _____ (Deputy)