


Township 6N Range 35E W.M.
North

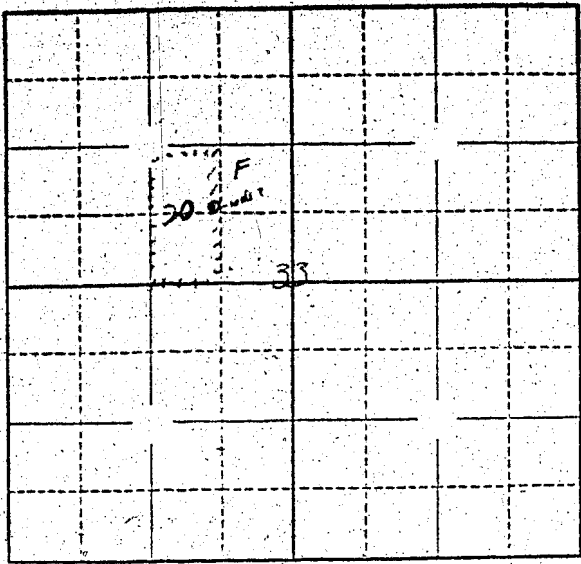

Locate well and acreage of irrigated land on plat.
Scale: $\frac{1}{4}$ " = 1 Mile

STATE OF OREGON

County of UMATILLA } ss.

I, Bert Pesciullo, being first duly sworn, do hereby certify that I have read the foregoing Registration Statement and that all of the items therein contained are true to the best of my knowledge and belief.

Bert Pesciullo
(Signature of Registrant)

Subscribed and sworn to before me this 1st day of April, 1955

My commission expires Mar. 27, 1959

(Notary Public)

(SEAL)

CERTIFICATE OF REGISTRATION

STATE OF OREGON

County of Marion } ss.

This is to certify that the foregoing Registration Statement was received in the office of the State Engineer on the 2nd day of April, 1955, at 1.00 o'clock P.M. and has been duly recorded in said office in Book No. 6 of Registration Statements on page GR-1278

Witness my hand this 20th day of October, 1958

Lewis J. Stanley
(State Engineer)

By _____ (Deputy)