


North

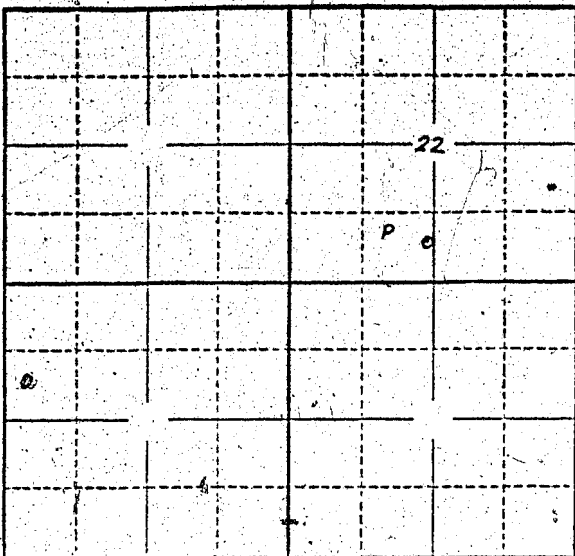

Locate well and acreage of irrigated land on plat.

Scale: 2" = 1 Mile

4"

STATE OF OREGON

County of Lane

ss.

I, \_\_\_\_\_ being first duly sworn, do hereby certify that I have read the foregoing Registration Statement and that all of the items therein contained are true to the best of my knowledge and belief.

*Jane Linton Elizabeth Linton*  
(Signature of Register)

Subscribed and sworn to before me this 31st day of March, 1958.

My commission expires \_\_\_\_\_  
NOTARY PUBLIC FOR OREGON  
My Commission Expires Oct. 16, 1959

*Robert S. Linn*  
(Notary Public)

(SEAL)

CERTIFICATE OF REGISTRATION

STATE OF OREGON

County of Marion

ss.

This is to certify that the foregoing Registration Statement was received in the office of the State Engineer on the 1st day of April, 1958, at 8:00 o'clock A.M. and has been duly recorded in said office in Book No. 6 of Registration Statements on page GR-1303

Witness my hand this 20th day of October, 1958

*Lura A. Stanley*  
(State Engineer)

By \_\_\_\_\_

(Deputy)