Drawing attached

Township 15 Range 2W, W.M.

North

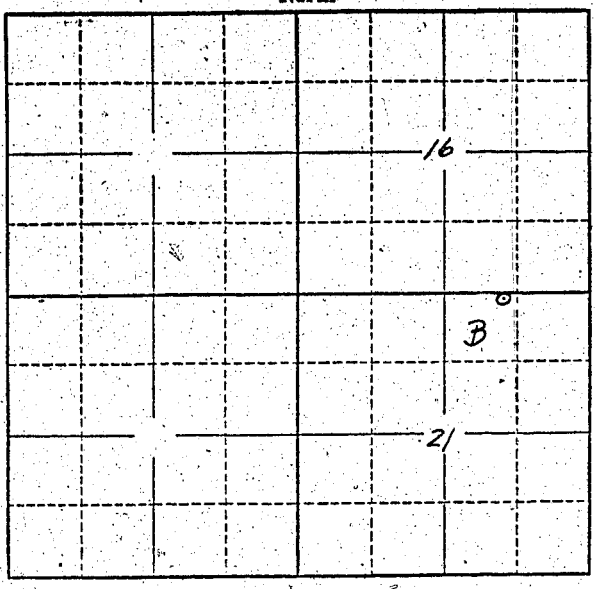

Locate well and acreage of irrigated land on plat.

Scale: 2" — 1 Mile

STATE OF OREGON
County of ..... } ss.

We ~~I~~ Emmett E. & Amy E. Woodward, being first duly sworn, do hereby certify that I have read the foregoing Registration Statement and that all of the items therein contained are true to the best of my knowledge and belief.

E.E. Woodward
Amy E. Woodward
(Signature of Registrant)

Subscribed and sworn to before me this 7th day of April, 1958.

My commission expires June 21, 1961

Neal P. Cox
(Notary Public)

(SEAL)

CERTIFICATE OF REGISTRATION

STATE OF OREGON
County of Marion } ss.

This is to certify that the foregoing Registration Statement was received in the office of the State Engineer on the 7th day of April, 19 58, at 8 o'clock A M. and has been duly recorded in said office in Book No. 11 of Registration Statements on page GR-2539

Witness my hand this 6th day of April, 19 59

Lewis A. Stanley
(State Engineer)

$15.00

By .....
(Deputy)

GR-2539