


North

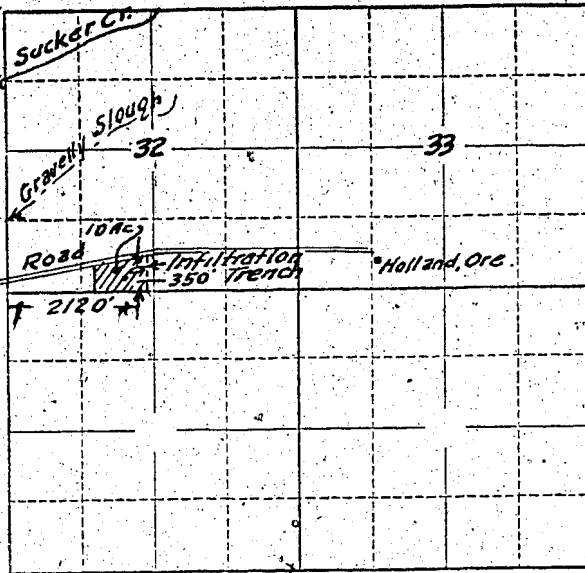

Locate well and acreage of irrigated land on plat.

Scale: 2" = 1 Mile

STATE OF OREGON

County of Josephine

} ss.

I, Keith Owen, being first duly sworn, do hereby certify that I have read the foregoing Registration Statement and that all of the items therein contained are true to the best of my knowledge and belief.

Keith Owen  
(Signature of Registrant)

Subscribed and sworn to before me this 4th day of April, 19 58

My commission expires Feb. 27, 1961

Mayson Green  
(Notary Public)

(SEAL)

**CERTIFICATE OF REGISTRATION**

STATE OF OREGON

County of Marion

} ss.

This is to certify that the foregoing Registration Statement was received in the office of the State Engineer on the 7th day of April, 1958, at 8:00 o'clock A.M. and has been duly recorded in said office in Book No. 6 of Registration Statements on page GR 1309

~~Construction shall be completed by 10 and the water completely applied to the fields by 10~~

Witness my hand this 20th day of October, 19 58

Laura A. Stanley  
(State Engineer)

By \_\_\_\_\_ (Deputy)

GR 1309