


Township 16 S Range 4 W W, W.M.
North

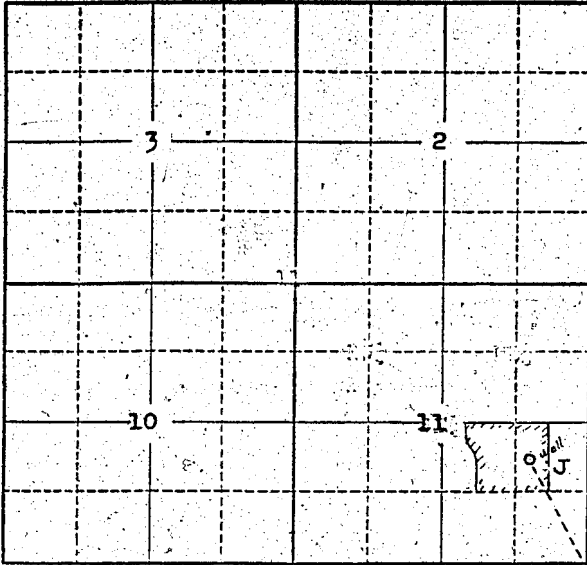

Locate well and acreage of irrigated land on plat.

Scale: 2" = 1 Mile

STATE OF OREGON

County of Linn } ss.

I, Waldemar Christensen, being first duly sworn, do hereby certify that I have read the foregoing Registration Statement and that all of the items therein contained are true to the best of my knowledge and belief.

Waldemar Christensen
(Signature of Registrant)

Subscribed and sworn to before me this 1st day of April, 19 58

My commission expires Aug. 10, 1959

Ray John
(Notary Public)

(SEAL)

CERTIFICATE OF REGISTRATION

STATE OF OREGON } ss.
County of Marion

This is to certify that the foregoing Registration Statement was received in the office of the State Engineer on the 7th day of April, 19 58, at 8:00 o'clock A. M. and has been duly recorded in said office in Book No. 6 of Registration Statements on page GR-1313

Witness my hand this 20th day of October, 19 58

Lewis A. Stanley
(State Engineer)

By _____ (Deputy)

GR - 1313

#16-25