


North

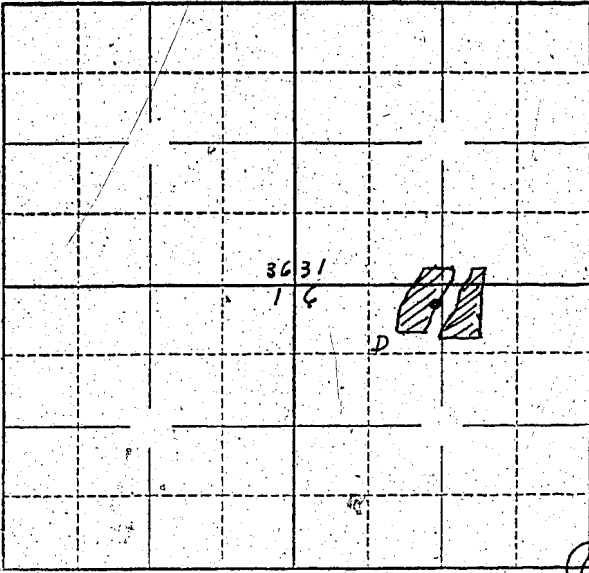

Locate well and acreage of irrigated land on plat.  
Scale: 2" = 1 Mile  
4"

STATE OF OREGON

County of Yamhill

ss.

I, Edward F. & Wilmetta Schroeder, being first duly sworn, do hereby certify that I have read the foregoing Registration Statement and that all of the items therein contained are true to the best of my knowledge and belief.

Edward F. Schroeder  
Wilmetta Schroeder  
(Signature of Registrant)

Subscribed and sworn to before me this 21st day of March, 1958.

My commission expires May 23, 1960

Stanley A. Stanley  
(Notary Public)

(SEAL)

**CERTIFICATE OF REGISTRATION**

STATE OF OREGON

County of Marion

ss.

This is to certify that the foregoing Registration Statement was received in the office of the State Engineer on the 7th day of April, 1958, at 3:30 o'clock P. M. and has been duly recorded in said office in Book No. 6 of Registration Statements on page GR-1331

~~Construction shall be completed by \_\_\_\_\_ 19\_\_\_\_ and the water completely applied to beneficial use by \_\_\_\_\_ 19\_\_\_\_.~~

Witness my hand this 20th day of October, 1958.

Lewis A. Stanley  
(State Engineer)

By \_\_\_\_\_ (Deputy)

\$ 15.00