


North

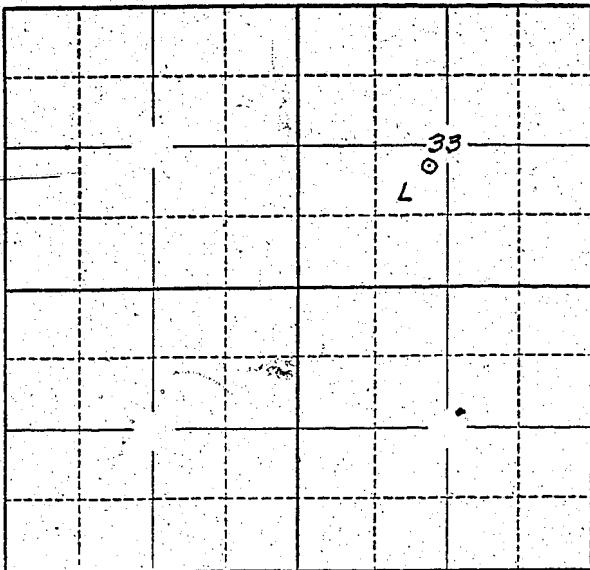

Locate well and acreage of irrigated land on plat.

Scale: 2" = 1 Mile

STATE OF OREGON

County of Lane } ss.

I, James B. Crowson and Sarah Frances Crowson, being first duly sworn, do hereby certify that I have read the foregoing Registration Statement and that all of the items therein contained are true to the best of my knowledge and belief.

James B. Crowson
(Signature of Registrant)

Subscribed and sworn to before me this 8th day of April 19 58

My commission expires March 13, 1961

James M. Dean
(Notary Public)

(SEAL)

CERTIFICATE OF REGISTRATION

STATE OF OREGON } ss.
County of Marion

This is to certify that the foregoing Registration Statement was received in the office of the State Engineer on the 7th day of April, 19 58, at 3:00 o'clock P. M. and has been duly recorded in said office in Book No. 17 of Registration Statements on page GR-1402

Witness my hand this 20th day of October 19 58

\$ 15.00

Lewis A. Stanley
(State Engineer)

By _____ (Deputy)