


Township 55 Range 3W, W.M.

North

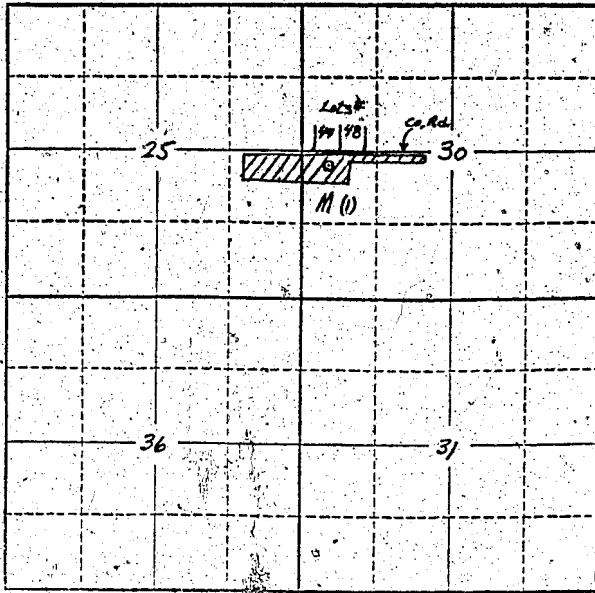

Locaté well and acreage of irrigated land on plat.
Scale: 2" = 1 Mile

STATE OF OREGON

County of _____ } ss.

I, Gust Janzen, being first duly sworn, do hereby certify that I have read the foregoing Registration Statement and that all of the items therein contained are true to the best of my knowledge and belief.

Gust Janzen
(Signature of Registrant)

Subscribed and sworn to before me this 6th day of March, 1956

My commission expires _____

(Notary Public)

(SEAL)

CERTIFICATE OF REGISTRATION

STATE OF OREGON }
County of Marion } ss.

This is to certify that the foregoing Registration Statement was received in the office of the State Engineer on the 6th day of March, 1956, at 1:30 o'clock P. M. and has been duly recorded in said office in Book No. 1 of Registration Statements on page GR-128C

~~Recorded in the office of the State Engineer on the _____ day of _____, 19____, at _____ o'clock _____ M. and has been duly recorded in said office in Book No. _____ of Registration Statements on page _____~~

Witness my hand this 12th day of April, 1956

Lewis J. Stanley
(State Engineer)

By _____
(Deputy)