


Township 7 S Range 4 W, W.M.
North

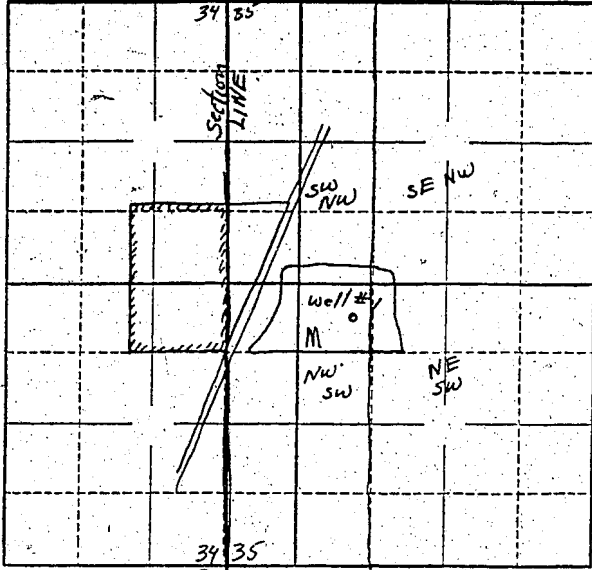

Locate well and acreage of irrigated land on plat.

Scale: 1 Mile

STATE OF OREGON
County of Marion } ss.

I, _____, being first duly sworn, do hereby certify that I have read the foregoing Registration Statement and that all of the items therein contained are true to the best of my knowledge and belief.

Walter H. Brown
(Signature of Registrant)

Subscribed and sworn to before me this 25th day of March, 19 58

My commission expires 12th June 1961

Wm S. Bartholomew
(Notary Public)

(SEAL)

CERTIFICATE OF REGISTRATION

STATE OF OREGON
County of Marion } ss.

This is to certify that the foregoing Registration Statement was received in the office of the State Engineer on the 8th day of April, 19 58, at 9:30 o'clock A.M. and has been duly recorded in said office in Book No. 6 of Registration Statements on page GR-1337

Witness my hand this 20th day of October, 19 58

Lewis A. Stanley
(State Engineer)

By _____
(Deputy)

SEC.35 T7S R4W WM
POLK COUNTY
Scale 1" = 400'

7.4.3B

See Map 7.4.25C

See Map 7.4.25

Canceled No.

200 A1
201

See Map 7.4.20

13-12

See Map 7.4.34

• See Map 7.4.30

T 12692

OW/RD

JUN 14 2017

RECEIVED

GR 1380 Modification

Irrigation - Priority Date: July 1944

