


Township 75 Range 3W, W.M.

North

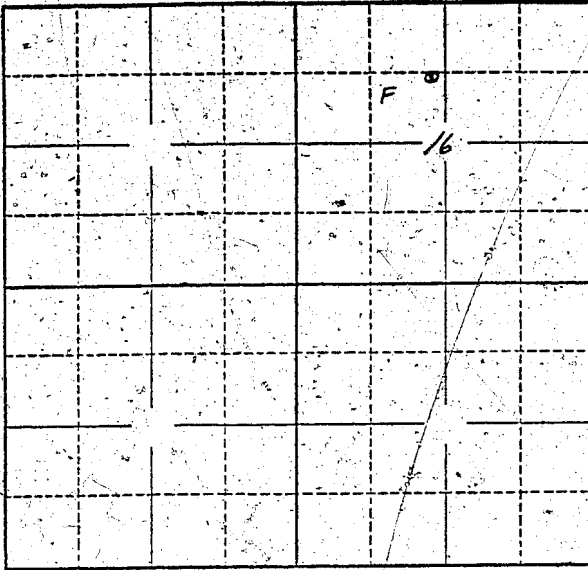

Locate well and acreage of irrigated land on plat.

Scale: 2" = 1 Mile

STATE OF OREGON

County of Marion

ss.

I, \_\_\_\_\_, being first duly sworn, do hereby certify that I have read the foregoing Registration Statement and that all of the items therein contained are true to the best of my knowledge and belief.

M. A. Stoutenberg  
(Signature of Registrar)

Subscribed and sworn to before me this 10th day of April, 1958

My commission expires 12th June 1961

Wm. S. Bartholomew  
(Notary Public)

(SEAL)

**CERTIFICATE OF REGISTRATION**

STATE OF OREGON

County of Marion

ss.

This is to certify that the foregoing Registration Statement was received in the office of the State Engineer on the 10th day of April, 1958, at 11:00 o'clock A.M. and has been duly recorded in said office in Book No. 7 of Registration Statements on page GR-1318

Witness my hand this 20th day of October, 1958

Laura A. Stanley  
(State Engineer)

By \_\_\_\_\_  
(Deputy)