


Township 6 N Range 35 E, W.M. North

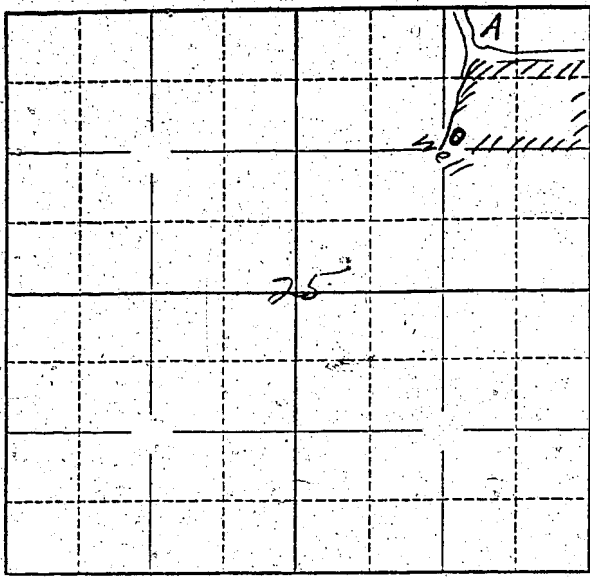

Locate well and acreage of irrigated land on plat.
Scale: 1/4 - 1 Mile

STATE OF ~~OREGON~~ MONTANA } ss.
County of Flathead

I, Vera Johnson Folkes, being first duly sworn, do hereby certify that I have read the foregoing Registration Statement and that all of the items therein contained are true to the best of my knowledge and belief.

Vera Johnson Folkes
(Signature of Registrant)

Subscribed and sworn to before me this 7th day of April, 1958.

My commission expires Jan. 2, 1959

Charles O. Drake
(Notary Public)

(SEAL)

CERTIFICATE OF REGISTRATION

STATE OF OREGON } ss.
County of Marion

This is to certify that the foregoing Registration Statement was received in the office of the State Engineer on the 10th day of April, 1958, at 1:00 o'clock P. M. and has been duly recorded in said office in Book No. 7 of Registration Statements on page GR-1319

Witness my hand this 20th day of October, 1958.

Lewis J. Stanley
(State Engineer)

By _____ (Deputy)