


Township 1-S Range 1-W, W.M.

North

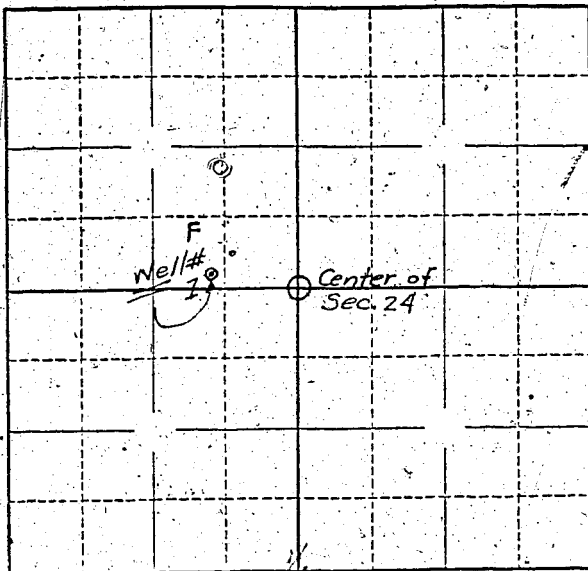

Locate well and acreage of irrigated land on plat.

Scale: 2" = 1 Mile

STATE OF OREGON

County of Multnomah } ss.

I, John W. Frank, being first duly sworn, do hereby certify that I have read the foregoing Registration Statement and that all of the items therein contained are true to the best of my knowledge and belief.

John W. Frank
(Signature of Registrant)

Subscribed and sworn to before me this 9 day of April, 1958

My commission expires April 27, 1959

Robert A. Eckhardt
(Notary Public)
for Oregon

(SEAL)

CERTIFICATE OF REGISTRATION

STATE OF OREGON

County of Marion } ss.

This is to certify that the foregoing Registration Statement was received in the office of the State Engineer on the 2nd day of April, 1958, at 2 o'clock P. M. and has been duly recorded in said office in Book No. 7 of Registration Statements on page GR-1563

Witness my hand this 1st day of December, 1958

Laura A. Stanley
(State Engineer)

By _____ (Deputy)

GR - 1563