Township 16 S Range 3 W, W.M.

North

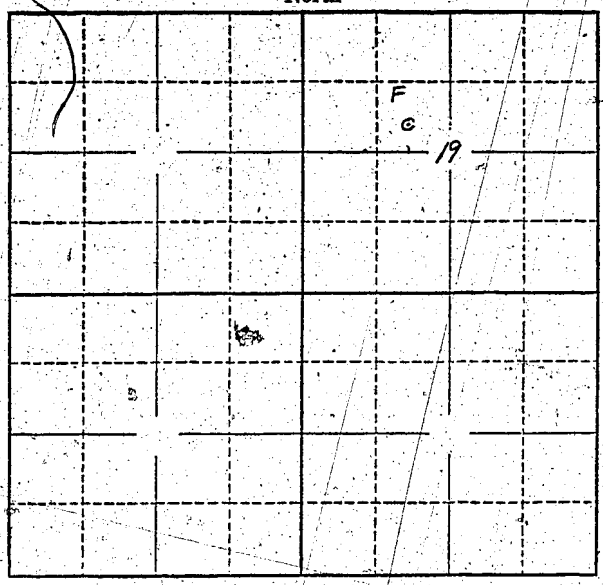

Locate well and acreage of irrigated land on plat.

Scale: 2" = 1 Mile

STATE OF OREGON
County of [illegible] } ss.

I, [illegible], being first duly sworn, do hereby certify that I have read the foregoing Registration Statement and that all of the items therein contained are true to the best of my knowledge and belief.

Charlie E. Vogel
(Signature of Registrant)

Subscribed and sworn to before me this 16 day of [illegible], 19[illegible]

My commission expires [illegible] 16 1959 [illegible]
(Notary Public)

(SEAL)

CERTIFICATE OF REGISTRATION

STATE OF OREGON
County of Marion } ss.

This is to certify that the foregoing Registration Statement was received in the office of the State Engineer on the 15th day of April, 1958, at 8:00 o'clock A M. and has been duly recorded in said office in Book No. 7 of Registration Statements on page GR-1363

Witness my hand this 20th day of October 19 58

Lewis A. Stanley
(State Engineer)

#15.00

By
(Deputy)

GR - 1363