


North

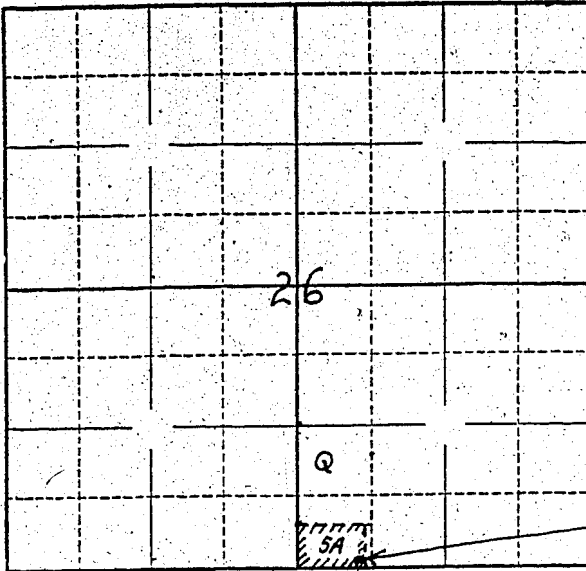

Locate well and acreage of irrigated land on plat.

Scale: $\frac{1}{4}$ " = 1 Mile

Well location
620.5 feet East +
75 feet North of S
1/4 Corner of Sec 26

STATE OF OREGON

County of Wasco

} ss.

I, James A. Hughes, being first duly sworn, do hereby certify that I have read the foregoing Registration Statement and that all of the items therein contained are true to the best of my knowledge and belief.

James A. Hughes
(Signature of Registrant)

Subscribed and sworn to before me this 14th day of April, 1958

My commission expires Aug 5, 1960
[Signature]
(Notary Public)

(SEAL)

CERTIFICATE OF REGISTRATION

STATE OF OREGON

County of Marion

} ss.

This is to certify that the foregoing Registration Statement was received in the office of the State Engineer on the 16th day of April, 1958, at 8:00 o'clock A. M. and has been duly recorded in said office in Book No. 7 of Registration Statements on page GR-1367.

Witness my hand this 20th day of October, 1958

Flora A. Stanley
(State Engineer)

By _____
(Deputy)