


Township 15 Range 3W, W.M.
North

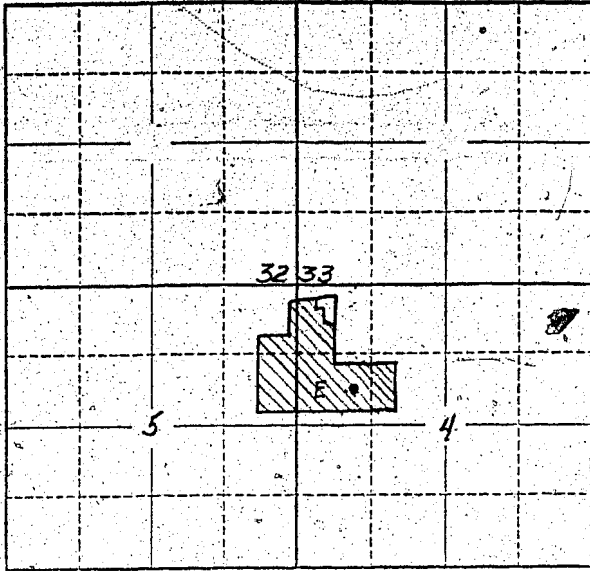

Locate well and acreage of irrigated land on plat.
Scale: 2" = 1 Mile

STATE OF OREGON

County of Washington } ss.

I, Dale Storking, being first duly sworn, do hereby certify that I have read the foregoing Registration Statement and that all of the items therein contained are true to the best of my knowledge and belief.

Dale Storking
(Signature of Registrant)

Subscribed and sworn to before me this 20th day of February, 1958

MY COMMISSION EXPIRES MARCH 21, 1959
E. H. [Signature]
(Notary Public)

(SEAL)

CERTIFICATE OF REGISTRATION

STATE OF OREGON } ss.
County of Marion

This is to certify that the foregoing Registration Statement was received in the office of the State Engineer on the 16th day of April, 1958, at 8:00 o'clock A. M. and has been duly recorded in said office in Book No. 7 of Registration Statements on page 6L-1370

~~Construction has been completed by [unclear] 19 [unclear] and the water completely applied to beneficial uses by [unclear] 19 [unclear].~~

Witness my hand this 20th day of October, 1958
Alvin A. Stanley
(State Engineer)

By _____ (Deputy)
6L-1370

1958