Township 9S Range 4W, W.M.

North

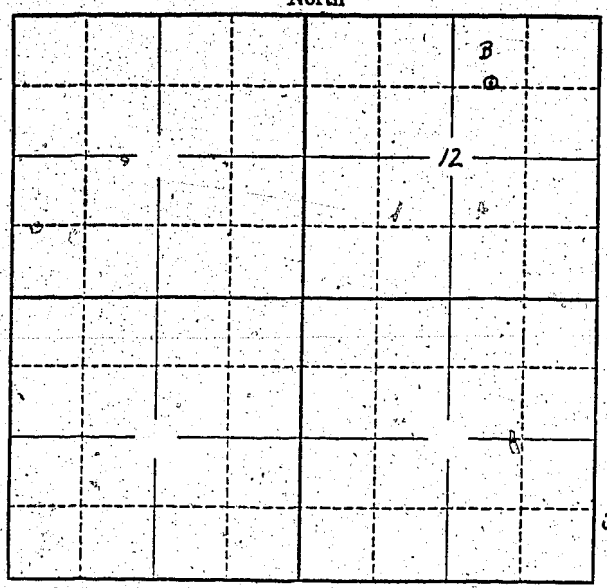

Locate well and acreage of irrigated land on plat.

Scale: 2" — 1 Mile

STATE OF OREGON
County of Crook } ss.

I, ..., being first duly sworn, do hereby certify that I have read the foregoing Registration Statement and that all of the items therein contained are true to the best of my knowledge and belief.

Gerald Moulton
(Signature of Registrant)

Subscribed and sworn to before me this 15th day of April, 1958

My commission expires NOTARY PUBLIC FOR OREGON
My Commission Expires Jan. 27, 1959

Lucinda Fisher
(Notary Public)

(SEAL)

CERTIFICATE OF REGISTRATION

STATE OF OREGON
County of Marion } ss.

This is to certify that the foregoing Registration Statement was received in the office of the State Engineer on the 16th day of April, 1958, at 8:00 o'clock A M. and has been duly recorded in said office in Book No. 7 of Registration Statements on page GR-1371

Witness my hand this 20th day of October 19 58

Lewis A. Stanley
(State Engineer)

By .....
(Deputy)

#22.65

GR-1371