


Township 11 S Range 4 W W.M.
North

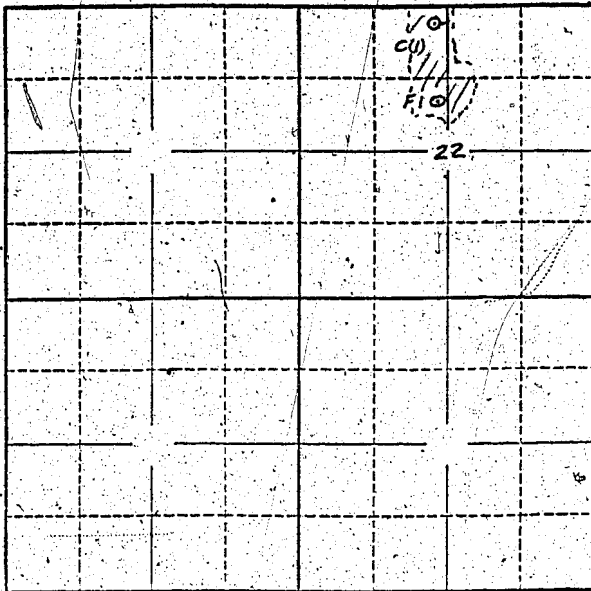

Locate well and acreage of irrigated land on plat.
Scale: 2" = 1 Mile

STATE OF OREGON

County of Linn

} ss.

I, Philip W. and Elizabeth Haddan, being first duly sworn, do hereby certify that I have read the foregoing Registration Statement and that all of the items therein contained are true to the best of my knowledge and belief.

Elizabeth E. Haddan

Philip W. Haddan
(Signature of Registrant)

Subscribed and sworn to before me this 29 day of February, 1956.

My commission expires June 13, 1958.

Alfred W. Benson
Notary Public for Oregon.
(Notary Public)

(SEAL)

CERTIFICATE OF REGISTRATION

STATE OF OREGON

County of Marion

} ss.

This is to certify that the foregoing Registration Statement was received in the office of the State Engineer on the 8th day of March, 1956, at 8 o'clock A.M. and has been duly recorded in said office in Book No. 1 of Registration Statements on page GR-136 C.

~~Construction shall be completed by 1958 and the water completely applied to beneficial use by 1958.~~

Witness my hand this 8th day of October, 1956.

Lewis A. Stanley
(State Engineer)

By _____ (Deputy)