SW¼ Sec 2, SE¼ Sec. 3, NE¼ Sec 10, NW¼ Sec 11

Township 4 S Range 4 W, W.M.

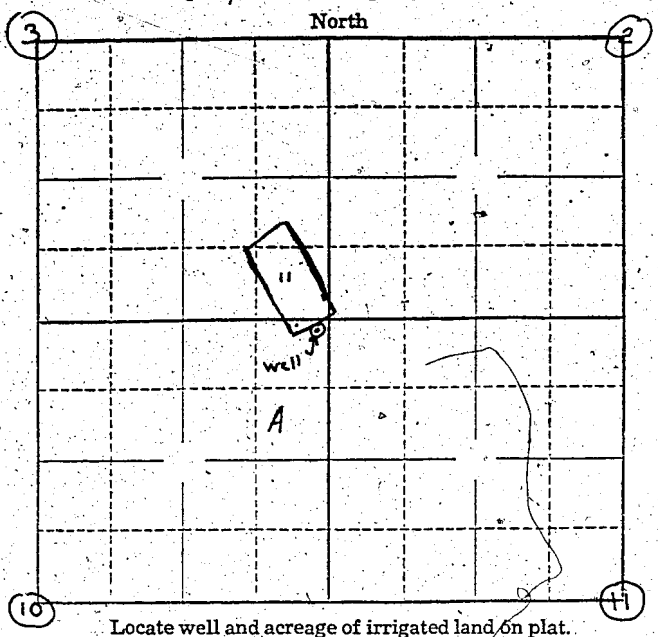

Locate well and acreage of irrigated land on plat.

Scale: 2" = 1 Mile

STATE OF OREGON
County of Marion } ss.

I, [illegible], being first duly sworn, do hereby certify that I have read the foregoing Registration Statement and that all of the items therein contained are true to the best of my knowledge and belief.

[illegible]
(Signature of Registrant)

Subscribed and sworn to before me this 1st day of [illegible], 19[illegible]

My commission expires [illegible]

[illegible]
(Notary Public)

(SEAL)

CERTIFICATE OF REGISTRATION

STATE OF OREGON
County of Marion } ss.

This is to certify that the foregoing Registration Statement was received in the office of the State Engineer on the 16th day of April, 1958, at 9:30 o'clock A M. and has been duly recorded in said office in Book No. 7 of Registration Statements on page GR-1378

~~Construction shall be completed by ..... 19xx and the water completely applied to beneficial use by ..... 19xx.~~

Witness my hand this 20th day of October, 1958.

Lewis A. Stanley
(State Engineer)

By ..... (Deputy)

$15.00

GR-1378