


Township 7S Range 3W, W.M.
North

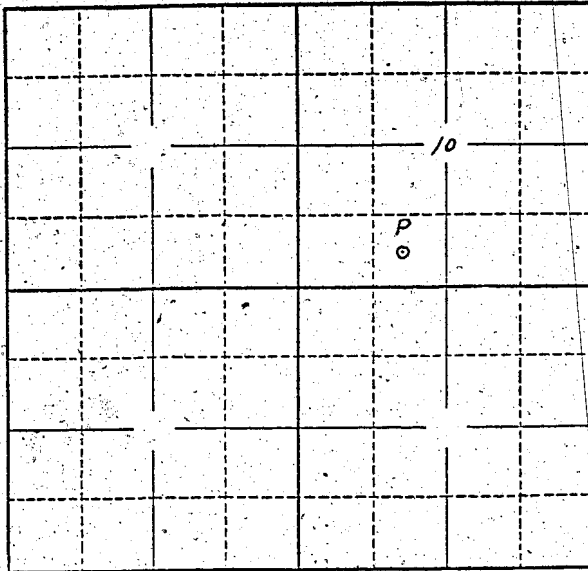

Locate well and acreage of irrigated land on plat.
Scale: 2" = 1 Mile

STATE OF OREGON

County of Marion } ss.

I, Willard Bacheller, being first duly sworn, do hereby certify that I have read the foregoing Registration Statement and that all of the items therein contained are true to the best of my knowledge and belief.

Willard Bacheller
(Signature of Registrant)

Subscribed and sworn to before me this 17th day of April, 1958

My commission expires 12th June 1961 Wm. J. Bartholomew
(Notary Public)

(SEAL)

CERTIFICATE OF REGISTRATION

STATE OF OREGON

County of Marion } ss.

This is to certify that the foregoing Registration Statement was received in the office of the State Engineer on the 17th day of April, 1958, at 11:50 o'clock A M. and has been duly recorded in said office in Book No. 7 of Registration Statements on page OK 1381

Witness my hand this 20th day of October, 1958

Lewis A. Stanley
(State Engineer)

By _____ (Deputy)