


North

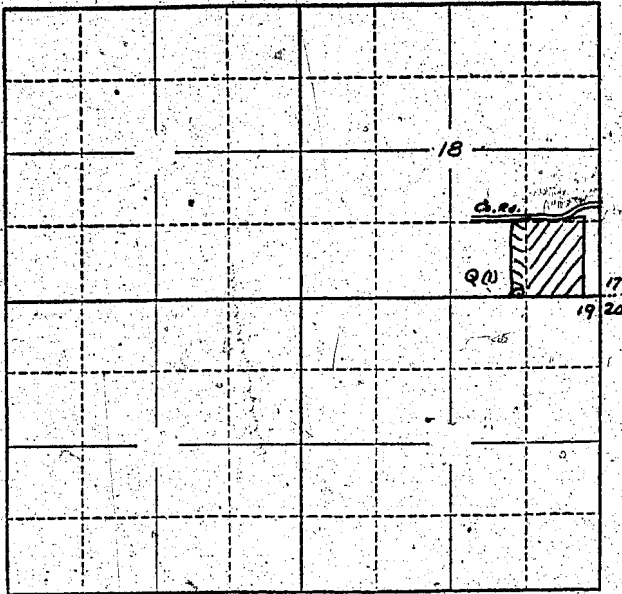

Locate well and acreage of irrigated land on plat.

Scale: 2" = 1 Mile

STATE OF OREGON

County of Linn } ss.

I, George W. and Elsie Schwab, being first duly sworn, do hereby certify that I have read the foregoing Registration Statement and that all of the items therein contained are true to the best of my knowledge and belief.

Elsie M. Schwab  
George W. Schwab  
(Signature of Registrant)

Subscribed and sworn to before me this 9th day of March, 1956

My commission expires \_\_\_\_\_  
W. M. Sull, County Clerk  
(Notary Public)

(SEAL)

**CERTIFICATE OF REGISTRATION**

STATE OF OREGON }  
County of Marion } ss.

This is to certify that the foregoing Registration Statement was received in the office of the State Engineer on the 13th day of March, 1956, at 8 o'clock A.M. and has been duly recorded in said office in Book No. 1 of Registration Statements on page GR-137 C

~~Construction shall be completed by \_\_\_\_\_, 19\_\_\_\_, and the water completely applied to beneficial use by \_\_\_\_\_, 19\_\_\_\_.~~

Witness my hand this 8th day of October, 1956

Levin A. Stanley  
(State Engineer)

By \_\_\_\_\_  
(Deputy)