


North

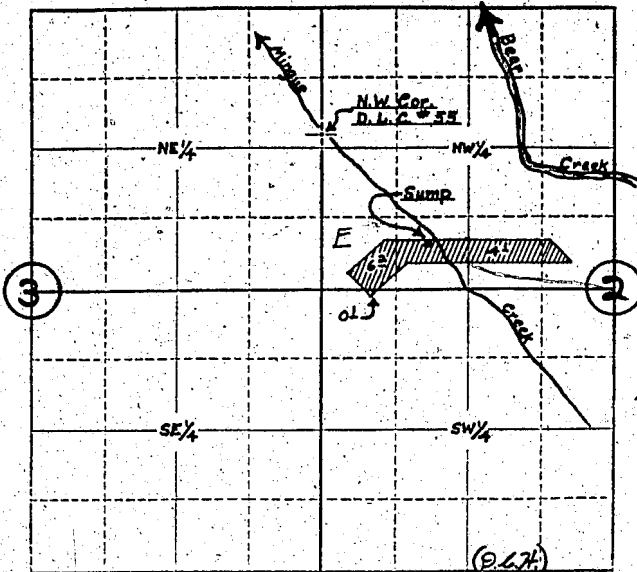

Locate well and acreage of irrigated land on plat.

Scale: 4" = 1 Mile

STATE OF OREGON

County of Jackson

} ss.

We, J. M. Weidman and Lillian C. Weidman, being first duly sworn, do hereby certify that I have read the foregoing Registration Statement and that all of the items therein contained are true to the best of my knowledge and belief.

Weidman

Signatures of J.M. Weidman and Lillian C. Weidman. (Signature of Registrant)

Subscribed and sworn to before me this 16th day of April, 1958

My commission expires August 25, 1958

Notary Public signature and name

(SEAL)

CERTIFICATE OF REGISTRATION

STATE OF OREGON

County of Marion

} ss.

This is to certify that the foregoing Registration Statement was received in the office of the State Engineer on the 17th day of April, 1958, at 8:00 o'clock P.M. and has been duly recorded in said office in Book No. 7 of Registration Statements on page GR 1289

Witness my hand this 20th day of October, 1958

Signature of Lewis A. Stanley, State Engineer

By (Deputy)

GR 1289