


North

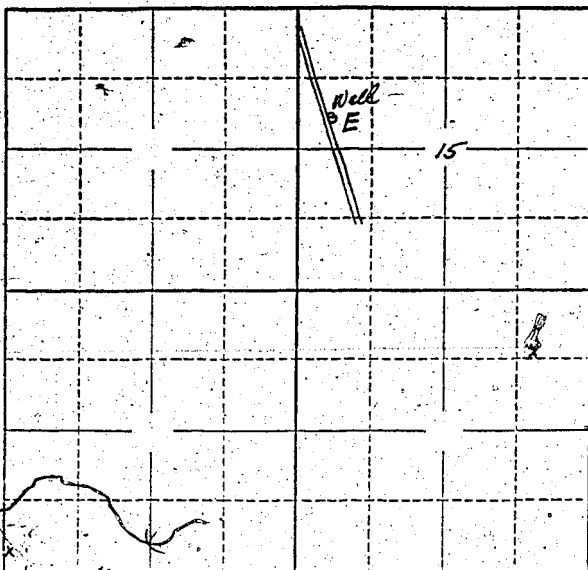

Locate well and acreage of irrigated land on plat.

Scale: 2" = 1 Mile

STATE OF OREGON

County of LANE } ss.

I, S. BERT SIMMONS, being first duly sworn, do hereby certify that I have read the foregoing Registration Statement and that all of the items therein contained are true to the best of my knowledge and belief.

Bert Simmons
(Signature of Registrant)

Subscribed and sworn to before me this 7th day of April, 1951.

My commission expires April 11, 1960.

John E. Smith
(Notary Public)

(SEAL)

CERTIFICATE OF REGISTRATION

STATE OF OREGON } ss.
County of Marion

This is to certify that the foregoing Registration Statement was received in the office of the State Engineer on the 15th day of April, 1951, at CC o'clock A.M. and has been duly recorded in said office in Book No. 7 of Registration Statements on page GR-1491.

~~Construction shall be completed by 1952 and the water completely applied to beneficial use by 1953~~

Witness my hand this 1st day of December, 1958.

Leura A. Anderson
(State Engineer)

By _____ (Deputy)