


Township 6 N Range 35 E W.M.
North

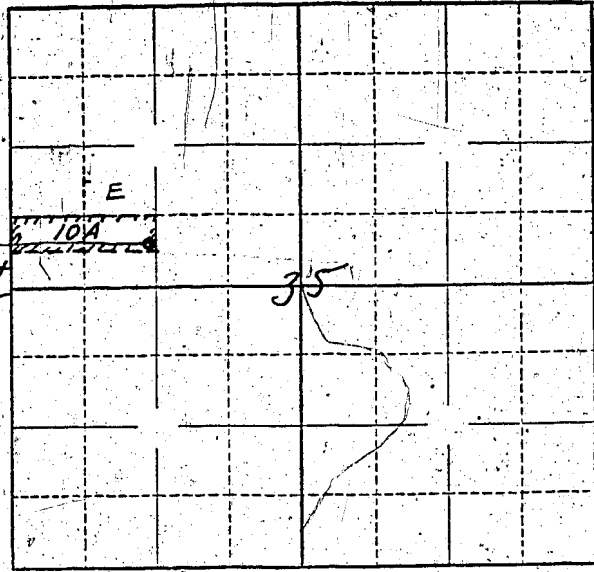

Well location
345 feet North & Point
West of SE Corner
of SW 1/4 of NW 1/4
of Sec 35

Locate well and acreage of irrigated land on plat.

Scale: $\frac{1}{4}$ - 1 Mile

STATE OF OREGON

County of Washington } ss.

I, Blaude Bradfield, being first duly sworn, do hereby certify that I have read the foregoing Registration Statement and that all of the items therein contained are true to the best of my knowledge and belief.

Blaude Bradfield
(Signature of Registrant)

Subscribed and sworn to before me this _____ day of _____, 19____

My commission expires Sept 9, 1937 _____ (Notary Public)

(SEAL)

CERTIFICATE OF REGISTRATION

STATE OF OREGON

County of Marion } ss.

This is to certify that the foregoing Registration Statement was received in the office of the State Engineer on the 26th day of April, 1935, at 5.00 o'clock P.M. and has been duly recorded in said office in Book No. 7 of Registration Statements on page GR-1295

Witness my hand this 20th day of October, 1958

Laura A. Stanley
(State Engineer)

By _____ (Deputy)