


Township 7 S Range 3 W, W.M.

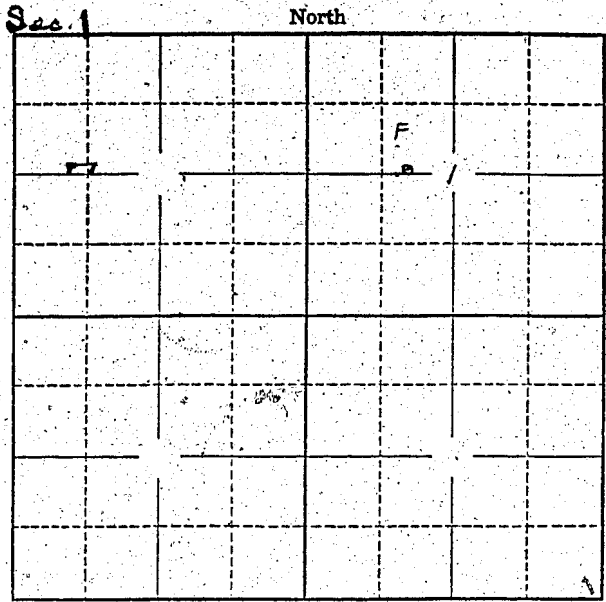

Locate well and acreage of irrigated land on plat.
Scale: 2" = 1 Mile

STATE OF OREGON

County of Marion

I, Elmer R. Fry being first duly sworn, do hereby certify that I have read the foregoing Registration Statement and that all of the items therein contained are true to the best of my knowledge and belief.

Elmer R. Fry
(Signature of Registrant)

Subscribed and sworn to before me this 21st day of April, 1958.

My commission expires April 3, 1961.

A. M. North
(Notary Public) for Oregon

(SEAL)

CERTIFICATE OF REGISTRATION

STATE OF OREGON

County of Marion

This is to certify that the foregoing Registration Statement was received in the office of the State Engineer on the 21st day of April, 1958, at 9:00 o'clock A. M. and has been duly recorded in said office in Book No. 7 of Registration Statements on page GR-1417

Witness my hand this 20th day of October, 1958

Lewis A. Stanley
(State Engineer)

By _____ (Deputy)

GR. 1417