


E 1/2 Sec 13 & W 1/2 Sec 12

Township 6 Range 2 W, W.M.

North

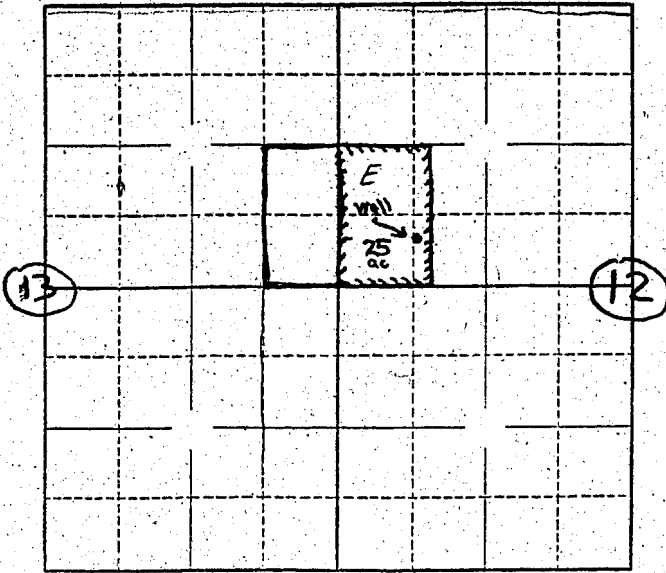

Locate well and acreage of irrigated land on plat.

Scale: 2" = 1 Mile

STATE OF OREGON

County of MARION } ss.

I, MARTIN SCHLECHTER, being first duly sworn, do hereby certify that I have read the foregoing Registration Statement and that all of the items therein contained are true to the best of my knowledge and belief.

Martin Schlechter  
(Signature of Registrant)

Subscribed and sworn to before me this 21<sup>st</sup> day of April, 1958.

My commission expires September 8 1960  
(Notary Public)

(SEAL)

**CERTIFICATE OF REGISTRATION**

STATE OF OREGON } ss.  
County of Marion

This is to certify that the foregoing Registration Statement was received in the office of the State Engineer on the 21<sup>st</sup> day of April, 1958, at 10<sup>00</sup> o'clock A M. and has been duly recorded in said office in Book No. 7 of Registration Statements on page GR-1418

Witness my hand this 20<sup>th</sup> day of October, 1958

Lewis A. Stanley  
(State Engineer)

By \_\_\_\_\_ (Deputy)

\$ 15.00