


Township 7S Range 2W W.M.

North

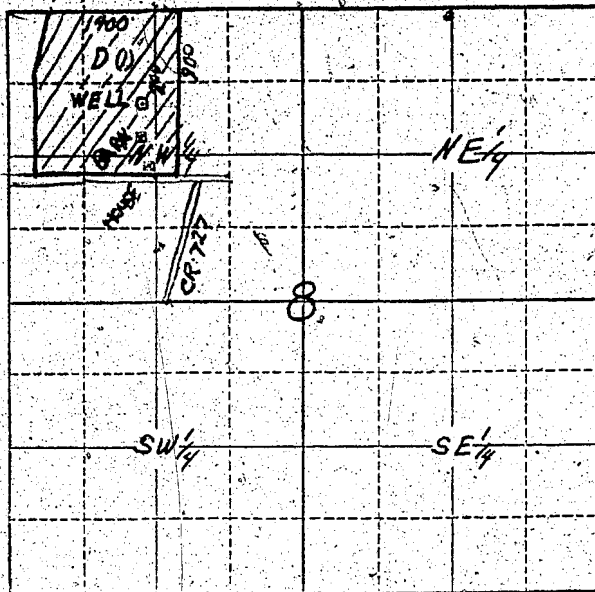

Locate well and acreage of irrigated land on plat.

Scale: $\frac{1}{4}$ \" = 1 Mile

STATE OF OREGON

County of _____

ss.

I, J. F. Abbott, being first duly sworn, do hereby certify that I have read the foregoing Registration Statement and that all of the items therein contained are true to the best of my knowledge and belief.

(Signature of Registrant)

Subscribed and sworn to before me this 23rd day of March, 1956.

My commission expires Sept. 8, 1956

(Notary Public)

(SEAL)

CERTIFICATE OF REGISTRATION

STATE OF OREGON

County of Marion

ss.

This is to certify that the foregoing Registration Statement was received in the office of the State Engineer on the 23rd day of March, 1956, at 10 o'clock A. M. and has been duly recorded in said office in Book No. 1 of Registration Statements on page GR-141 C.
Construction shall be completed by October 1, 1958 and the water completely applied to beneficial use by October 1, 1958.

Witness my hand this 8th day of October, 1956.

(State Engineer)

By _____

(Deputy)

GR-141 C