


North

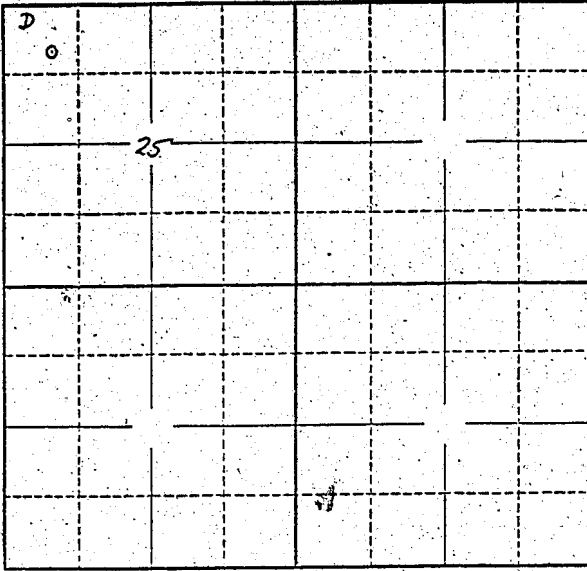

Locate well and acreage of irrigated land on plat.

Scale: 2" = 1 Mile

STATE OF OREGON

County of Linn } ss.

Harold J. Lister and Elma A Lister

I, Harold J. Lister and Elma A Lister, being first duly sworn, do hereby certify that I have read the foregoing Registration Statement and that all of the items therein contained are true to the best of my knowledge and belief.

Harold J. Lister Elma A. Lister
(Signature of Registrant)

Subscribed and sworn to before me this 19th day of April, 1958.

My commission expires

(Notary Public)

(SEAL)

NOTARY PUBLIC
My Commission Expires Sept. 25, 1958

CERTIFICATE OF REGISTRATION

STATE OF OREGON } ss.
County of Marion

This is to certify that the foregoing Registration Statement was received in the office of the State Engineer on the 21st day of April, 1958, at 8:00 o'clock A. M. and has been duly recorded in said office in Book No. 7 of Registration Statements on page 6R-1420

Witness my hand this 20th day of October, 1958

Lewis A. Stanley
(State Engineer)

By
(Deputy)

\$1,500