


North

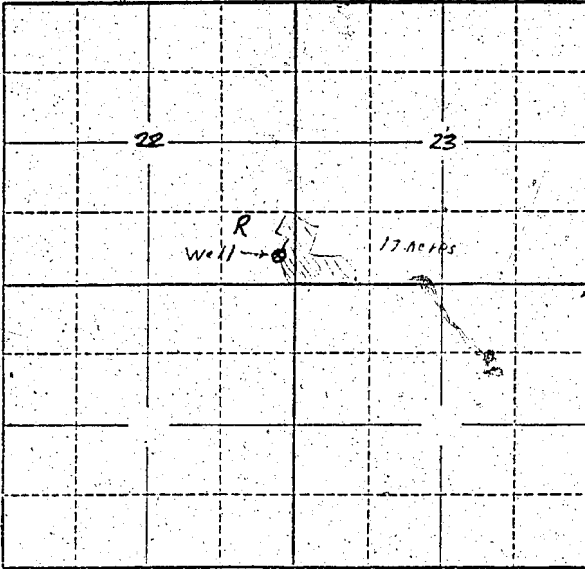

Locate well and acreage of irrigated land on plat.

Scale: 2" = 1 Mile

STATE OF OREGON


I, Melvin Becker being first duly sworn, do hereby certify that I have read the foregoing Registration Statement and that all of the items therein contained are true to the best of my knowledge and belief.

Melvin Becker
(Signature of Registrant)

Subscribed and sworn to before me this 17th day of April, 19 58

My commission expires Dec 11, 1959 H. Turner
(Notary Public)

(SEAL)

CERTIFICATE OF REGISTRATION

STATE OF OREGON }
County of Marion } ss.

This is to certify that the foregoing Registration Statement was received in the office of the State Engineer on the 22nd day of April, 1958, at 6:00 o'clock P. M. and has been duly recorded in said office in Book No. 7 of Registration Statements on page GR-1424

~~Construction shall be completed by 1958 and the water completed applied to the land by 1958~~

Witness my hand this 20th day of October, 19 58

Lewis A. Stanley
(State Engineer)

By _____ (Deputy)

1500