


North

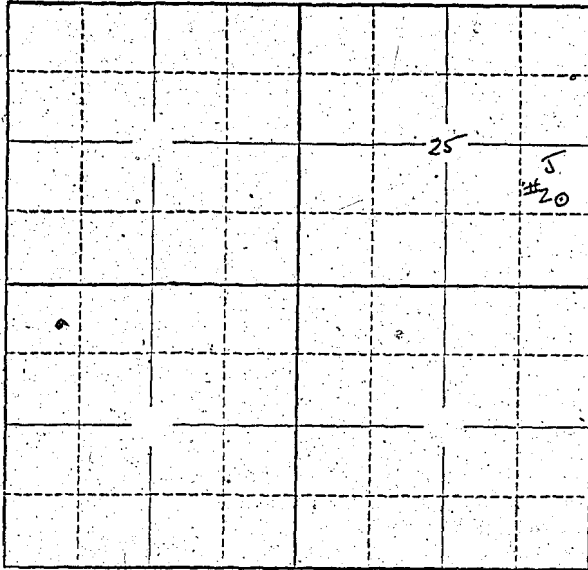

Locate well and acreage of irrigated land on plat.

Scale: 2" = 1 Mile

STATE OF OREGON

County of Polk } ss.

I, Edith B. Bennett, being first duly sworn, do hereby certify that I have read the foregoing Registration Statement and that all of the items therein contained are true to the best of my knowledge and belief:

City of Medford
Edith B. Bennett
(Signature of Registrant)

Subscribed and sworn to before me this 3 day of March, 1956.

My commission expires June 1, 1961

(Notary Public)

(SEAL)

CERTIFICATE OF REGISTRATION

STATE OF OREGON } ss.
County of Marion

This is to certify that the foregoing Registration Statement was received in the office of the State Engineer on the 22nd day of April, 1956, at 8:00 o'clock A. M. and has been duly recorded in said office in Book No. 7 of Registration Statements on page GR-1427

~~Construction shall be completed by 1959 and the water completely applied to beneficial use by 1960.~~

Witness my hand this 20th day of October, 1958

Leura A. Stanley
(State Engineer)

By _____ (Deputy)

GR-1427