


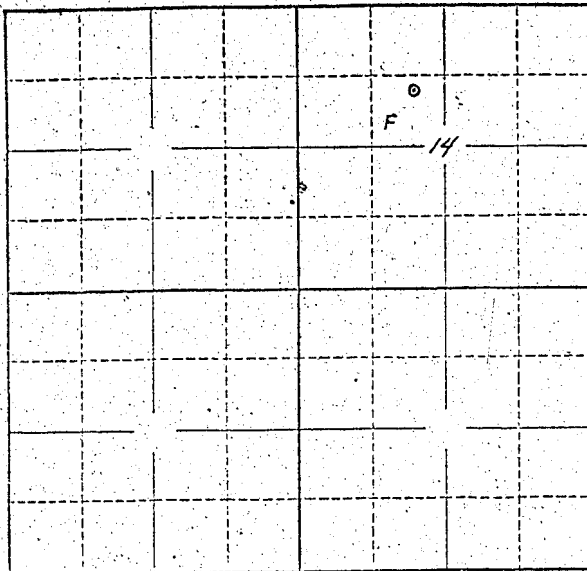

See map furnished
with this.

Locate well and acreage of irrigated land on plat.
Scale: 2" = 1 Mile

STATE OF OREGON

County of Marion

ss.

I, M. B. Clatterbuck, being first duly sworn, do hereby certify that I have read the foregoing Registration Statement and that all of the items therein contained are true to the best of my knowledge and belief.

M. B. Clatterbuck
(Signature of Registrant)

Subscribed and sworn to before me this 26th day of Feb, 1955.

My commission expires 7-19-59

Emerson R. Hart
(Notary Public)

(SEAL)

CERTIFICATE OF REGISTRATION

STATE OF OREGON

County of Marion

ss.

This is to certify that the foregoing Registration Statement was received in the office of the State Engineer on the 22 day of April, 1958, at 8:00 o'clock A. M. and has been duly recorded in said office in Book No. 7 of Registration Statements on page 6R-1431

~~Construction shall be completed by 12 o'clock and the water completely applied to beneficial use by 19 o'clock~~

Witness my hand this 1st day of December, 1958.

LEWIS L. STANLEY
(State Engineer)

By Max F. Rogers
(Deputy)

6R-1431