


85

Township 15 Range 2 W, W.M.
North

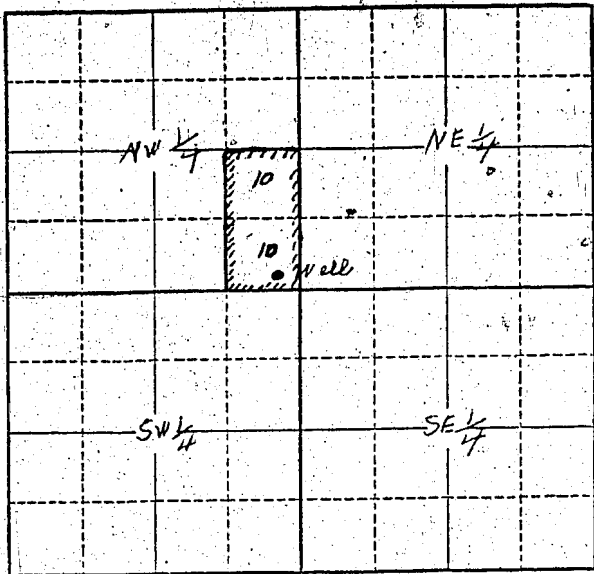

Locate well and acreage of irrigated land on plat.

Scale: \bullet = 1 Mile
 $4'' = 1 \text{ Mile}$

STATE OF OREGON

County of Washington } ss.

I, Caroline Mittle, being first duly sworn, do hereby certify that I have read the foregoing Registration Statement and that all of the items therein contained are true to the best of my knowledge and belief.

Caroline Mittle
(Signature of Registrant)

Subscribed and sworn to before me this 21st day of April, 1958

My commission expires 4-16-61
Notary Public
(Notary Public)

(SEAL)

CERTIFICATE OF REGISTRATION

STATE OF OREGON } ss.
County of Marion

This is to certify that the foregoing Registration Statement was received in the office of the State Engineer on the 23rd day of April, 1958, at 2:00 o'clock P. M. and has been duly recorded in said office in Book No. 7 of Registration Statements on page GR-1437

Witness my hand this 1st day of December, 1958
Lewis A. Standish
(State Engineer)

By _____
(Deputy)