


North

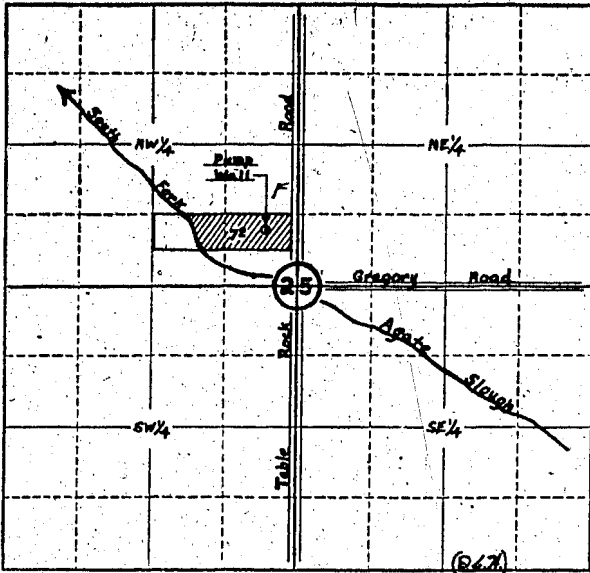

Locate well and acreage of irrigated land on plat.

Scale: 4" = 1 Mile

STATE OF OREGON

County of Jackson } ss.

I, Carl Hasler, being first duly sworn, do hereby certify that I have read the foregoing Registration Statement and that all of the items therein contained are true to the best of my knowledge and belief.

*Carl Hasler*  
(Signature of Registrant)

Subscribed and sworn to before me this 23rd day of April, 1958

My commission expires August 25, 1958

(Notary Public)

(SEAL)

CERTIFICATE OF REGISTRATION

STATE OF OREGON } ss.  
County of Marion

This is to certify that the foregoing Registration Statement was received in the office of the State Engineer on the 23rd day of April, 1958, at 1:00 o'clock P.M. and has been duly recorded in said office in Book No. 7 of Registration Statements on page GR-1449

Witness my hand this 1st day of December, 1958

*Lewis A. Starnes*  
(State Engineer)

By \_\_\_\_\_ (Deputy)